J-2
18285 7/06

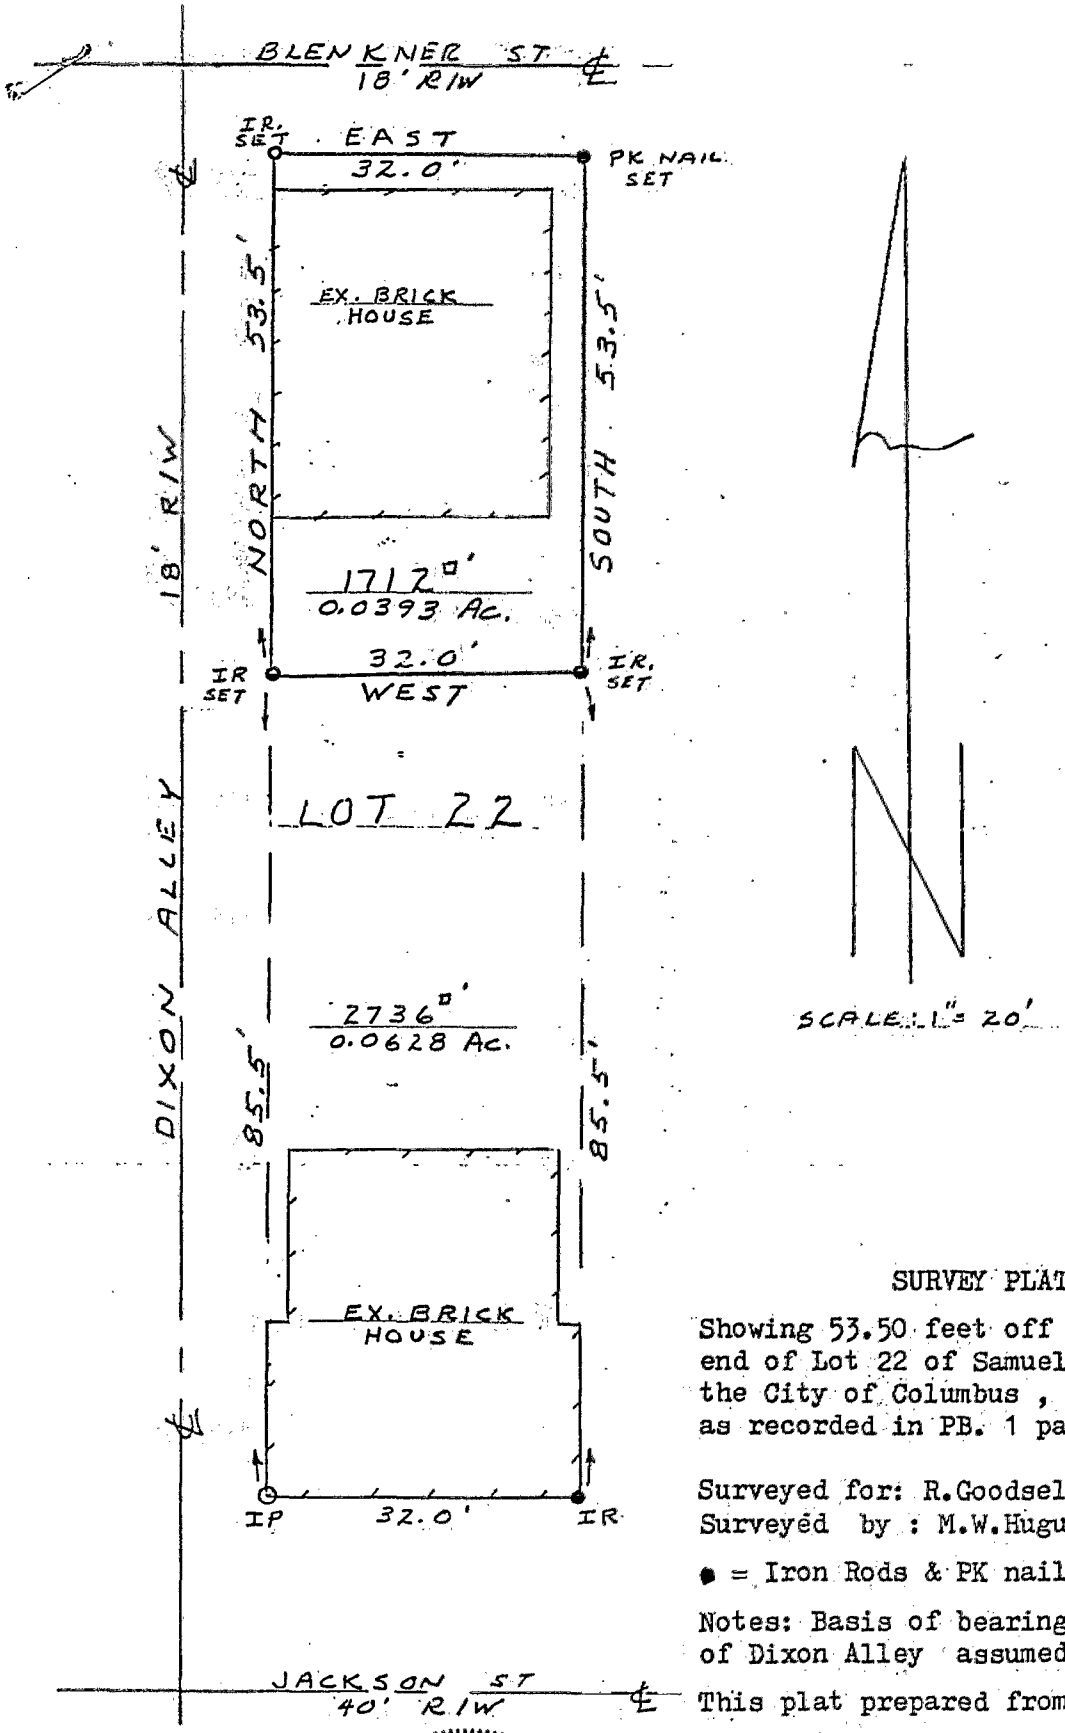

SURVEY PLAT

Showing 53.50 feet off of the entire North end of Lot 22 of Samuel Parsons Addition to the City of Columbus , Franklin County, Ohio as recorded in PB. 1 page 49 & DV. 3287 Pg. 343

Surveyed for: R.Goodsell 12 - 21 - 88
Surveyed by : M.W.Hugus Reg.Sur. # 4842

● = Iron Rods & PK nails Scale: 1" = 20'

Notes: Basis of bearings is the East R-W line of Dixon Alley assumed North.

This plat prepared from an actual field survey by M.W.Hugus - Reg. Sur. # 4842 .

12 - 21 - 88