H-59

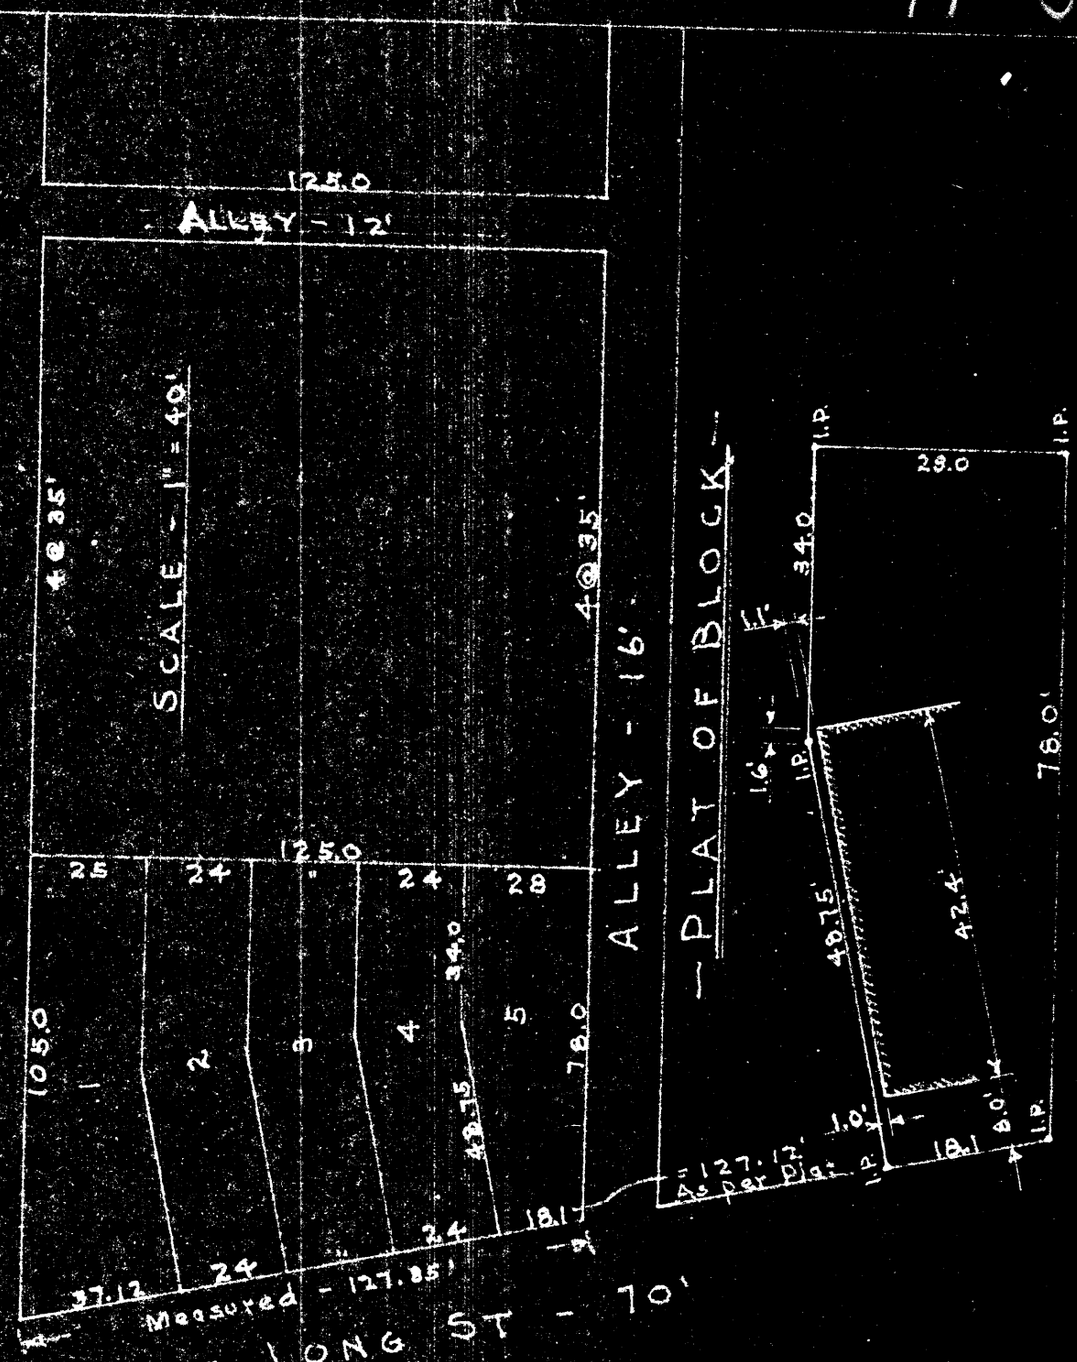

LECROKE'S SUBDIV.
RESURVEY BY
H.C McCall
Registered Surveyor
July 1952

Survey Book
#1 Page 274