

183607150

MYERS SURVEYING CO.

2740 East Main Street, Columbus 43209 (Bexley), Ohio

10-15


LOT 36 & PART OF LOT 37, WILSON & SHARP'S FIRST ADDN., COLUMBUS, OHIO
FOR

COLUMBUS HOUSING PARTNERSHIP

P.B. 2 Page 225
Scale 1" = 20'


MAC LEE ALLEY 20'

Franklin Co. Rec. Office
8-24-89

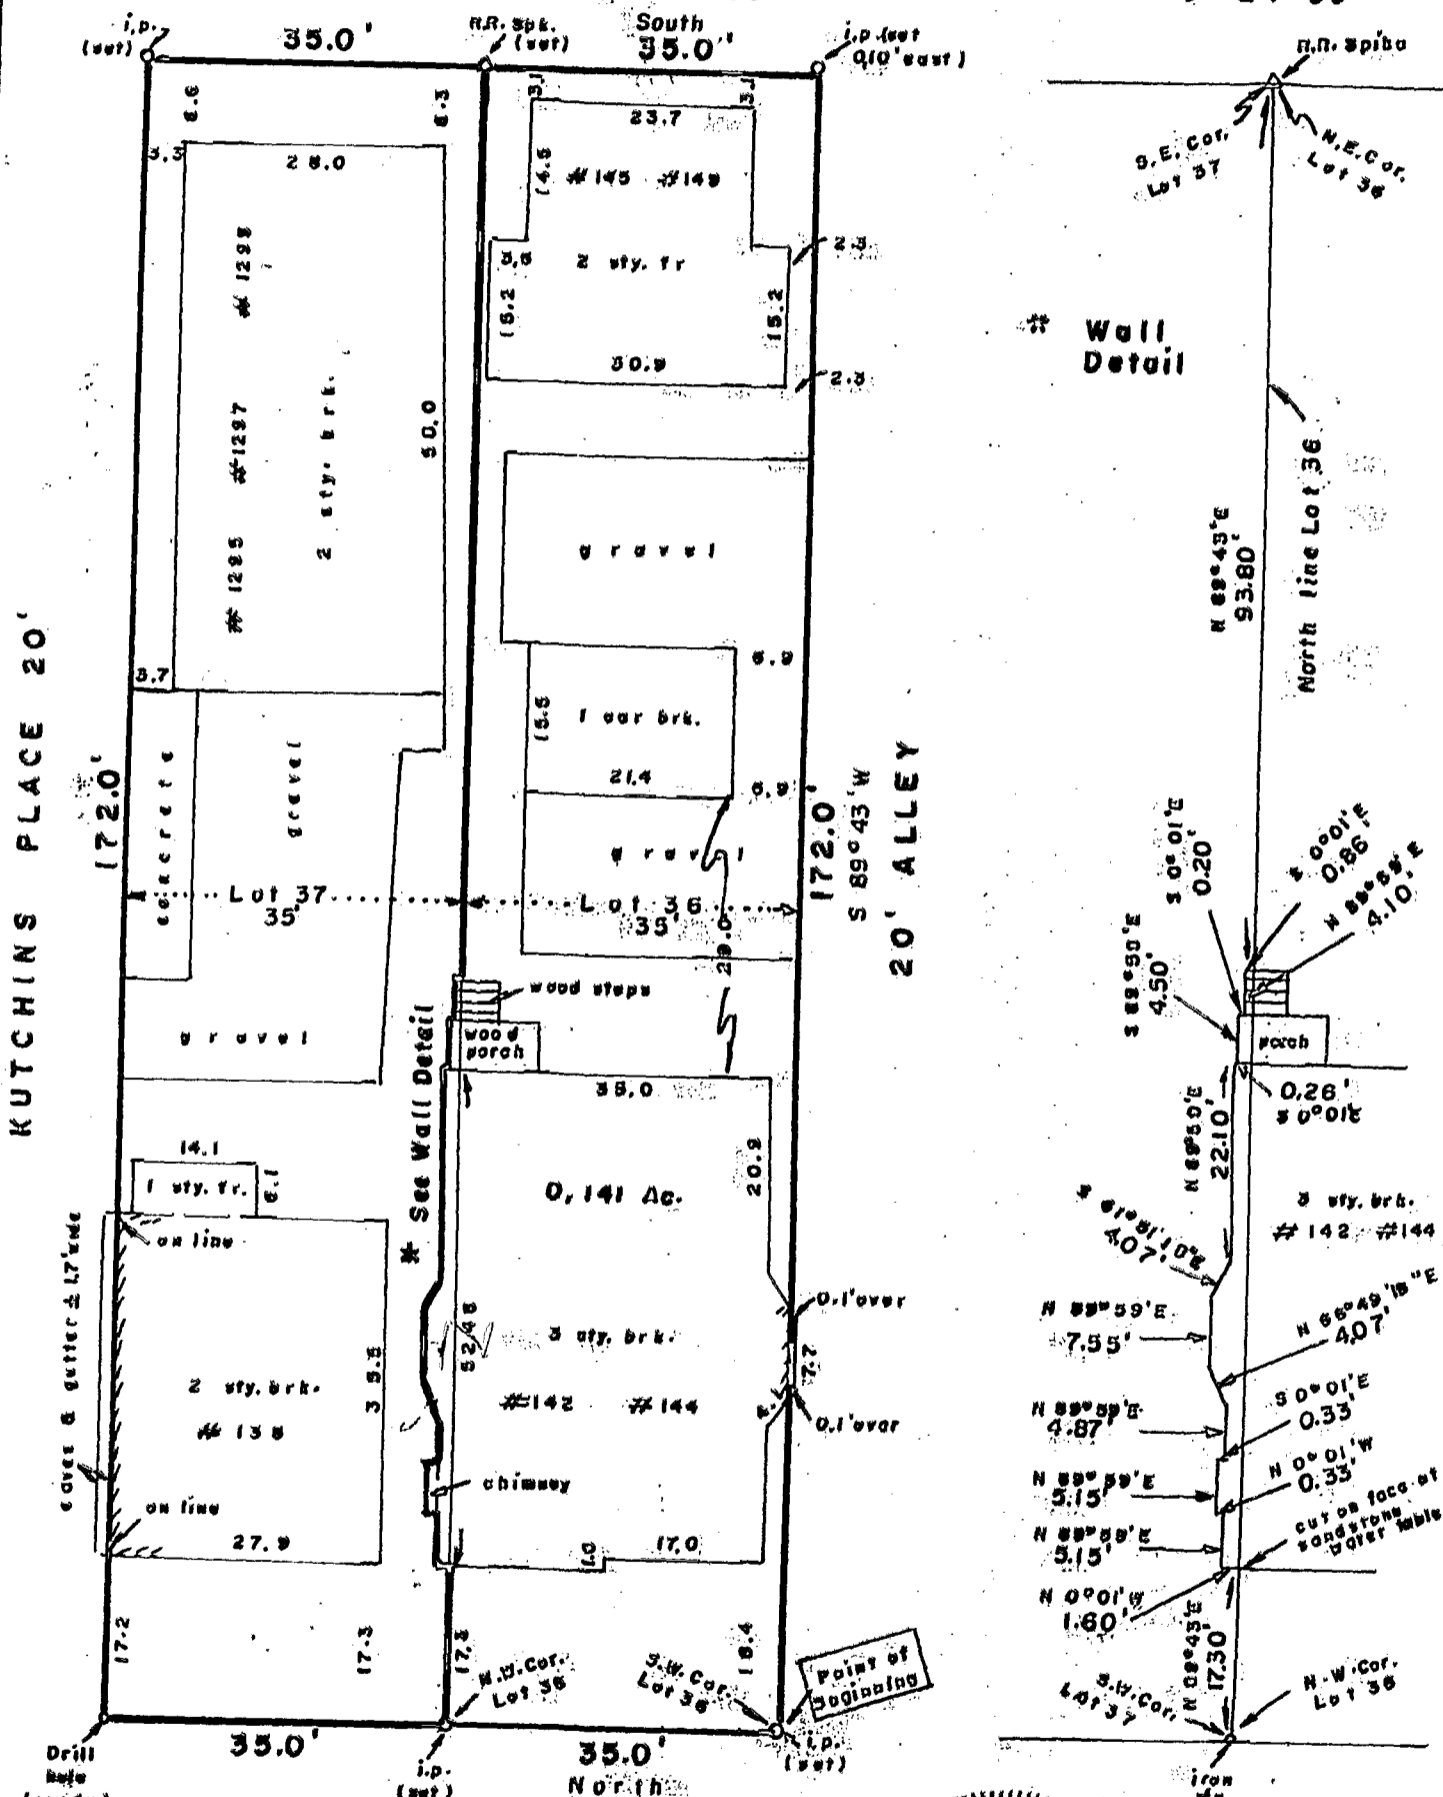

WILSON AVE. 60'

We hereby certify that the foregoing plat was prepared from an actual survey of the premises. Iron pins set are 30" x 1" O.D. with orange plastic caps inscribed "P.S. 6579". Basis of bearings is Wilson Avenue assumed NORTH.

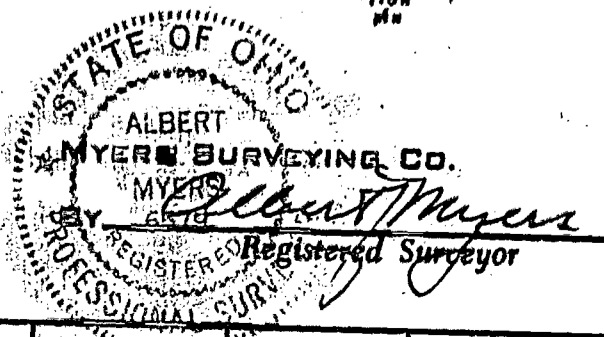

5-1