MYERS SURVEYING CO.
2740 East Main Street, Columbus 3 (Bexley), Ohio

PART OF LOTS 2, 3, 4, 5, 7 AND 8, PART VAC. ALLEY, ORD. 23254, O. A. A. VOGEL'S SUB., COLUMBUS, OHIO, FOR

18385 7/26

P.B. 4 Page 49
Scale 1" = 30'

Franklin Co. Rec. Office
11, 16, 1970

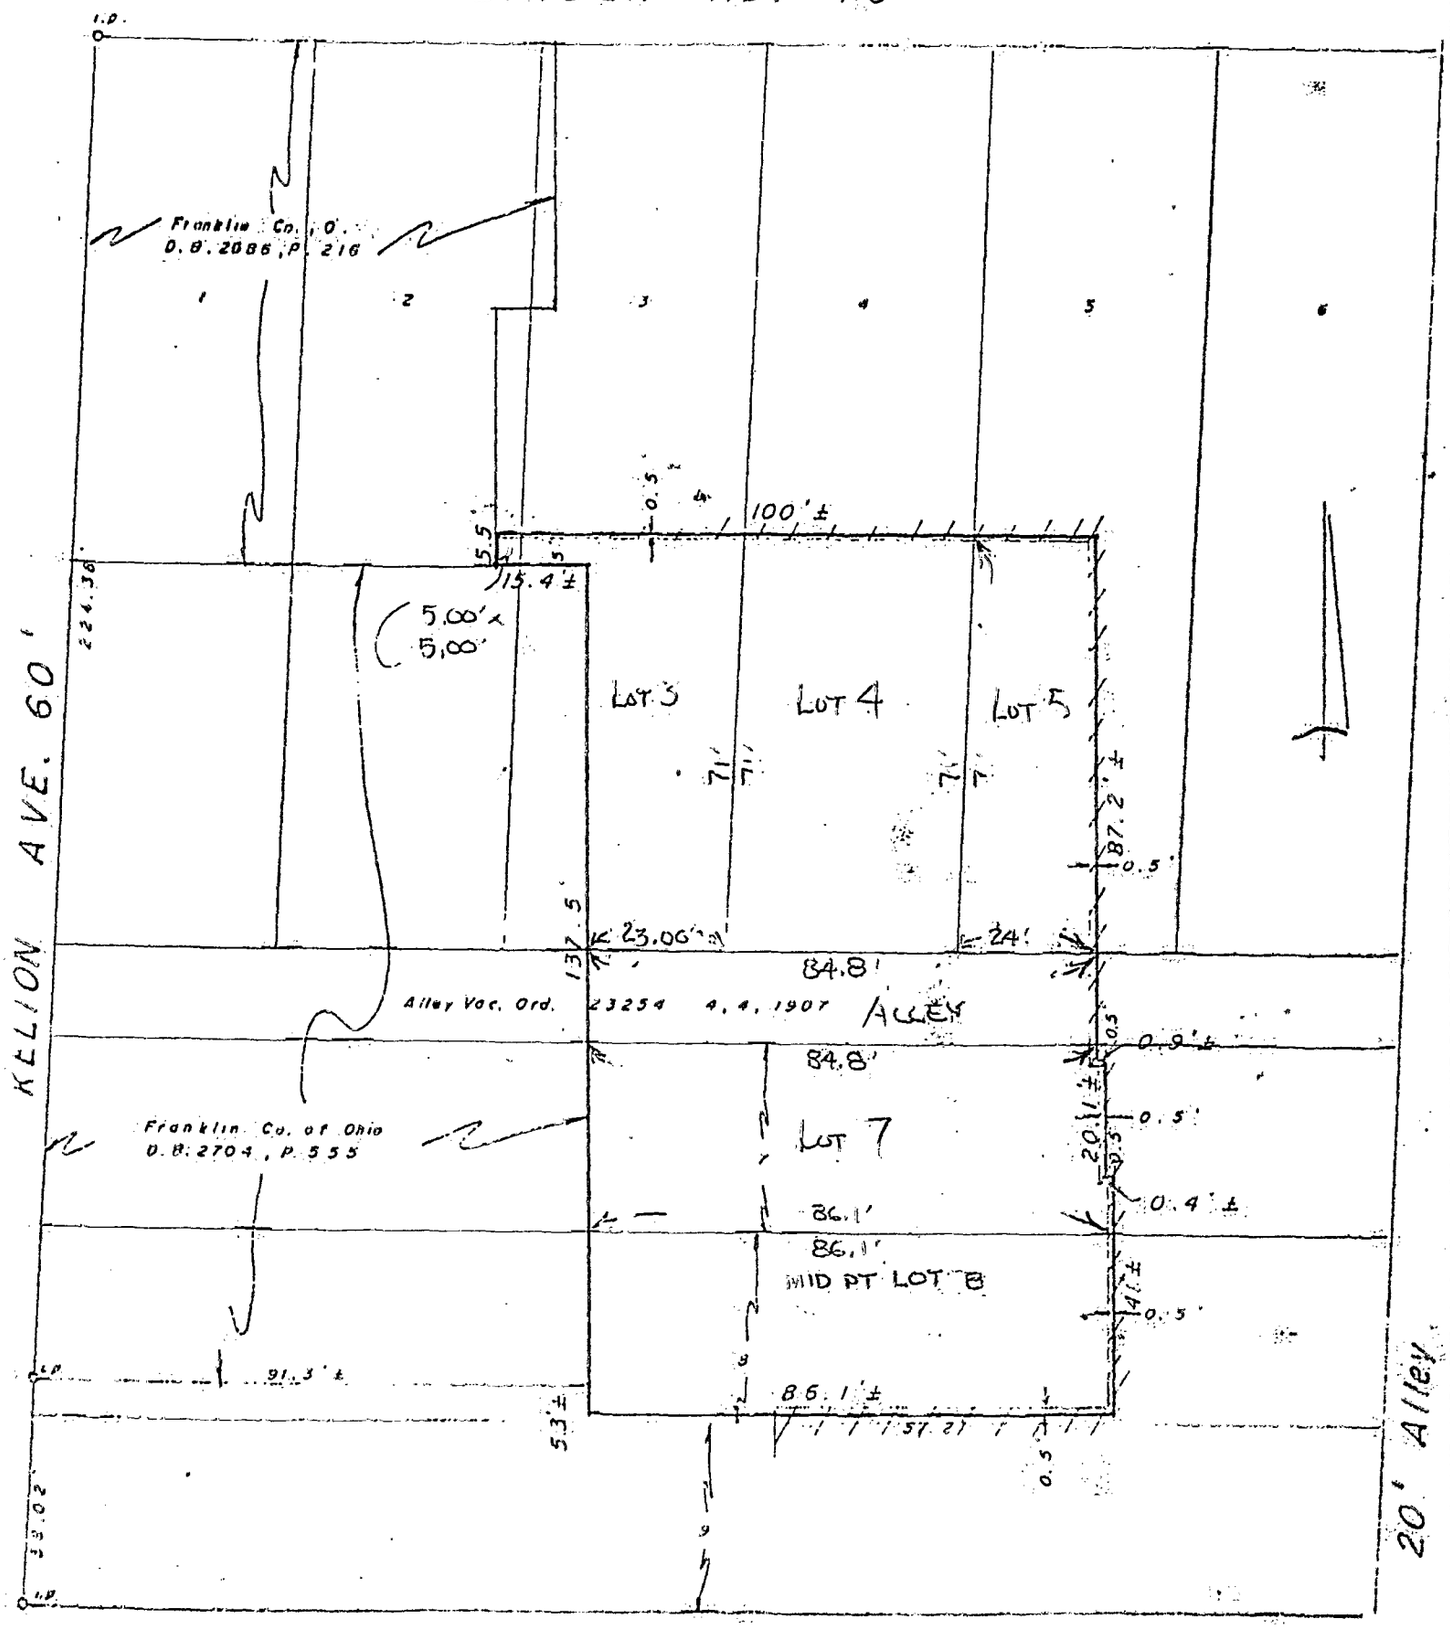

We hereby certify that the foregoing plat was prepared from an actual survey of the premises. Iron pins not set unless indicated thus.

MYERS SURVEYING CO.
BY _____
Registered Surveyor