18385' 7150

Myers Surveying Company, Inc.

2740 East Main Street, Columbus 43209 (Bexley), Ohio
614-235-8677 FAX: 614-235-4559

A Boundary Survey prepared for and certified to:
Columbus Title Agency Inc. and/or Bank One Columbus, N.A.

Legal Description: Situated in Ohio, County of Franklin, City of Columbus, Being Lot 16 and Part of Lot 15 Callender & Rockwell's Subdivision, Plat Book 4, Page 115.
Applicant: Mora
Posted Address: 55 Woodland Avenue, Columbus, Ohio
F.E.M.A. Flood Zone Designation: Flood Zone "C" as per F.I.R.M. 390170 0065B
Apparent Encroachments: None.

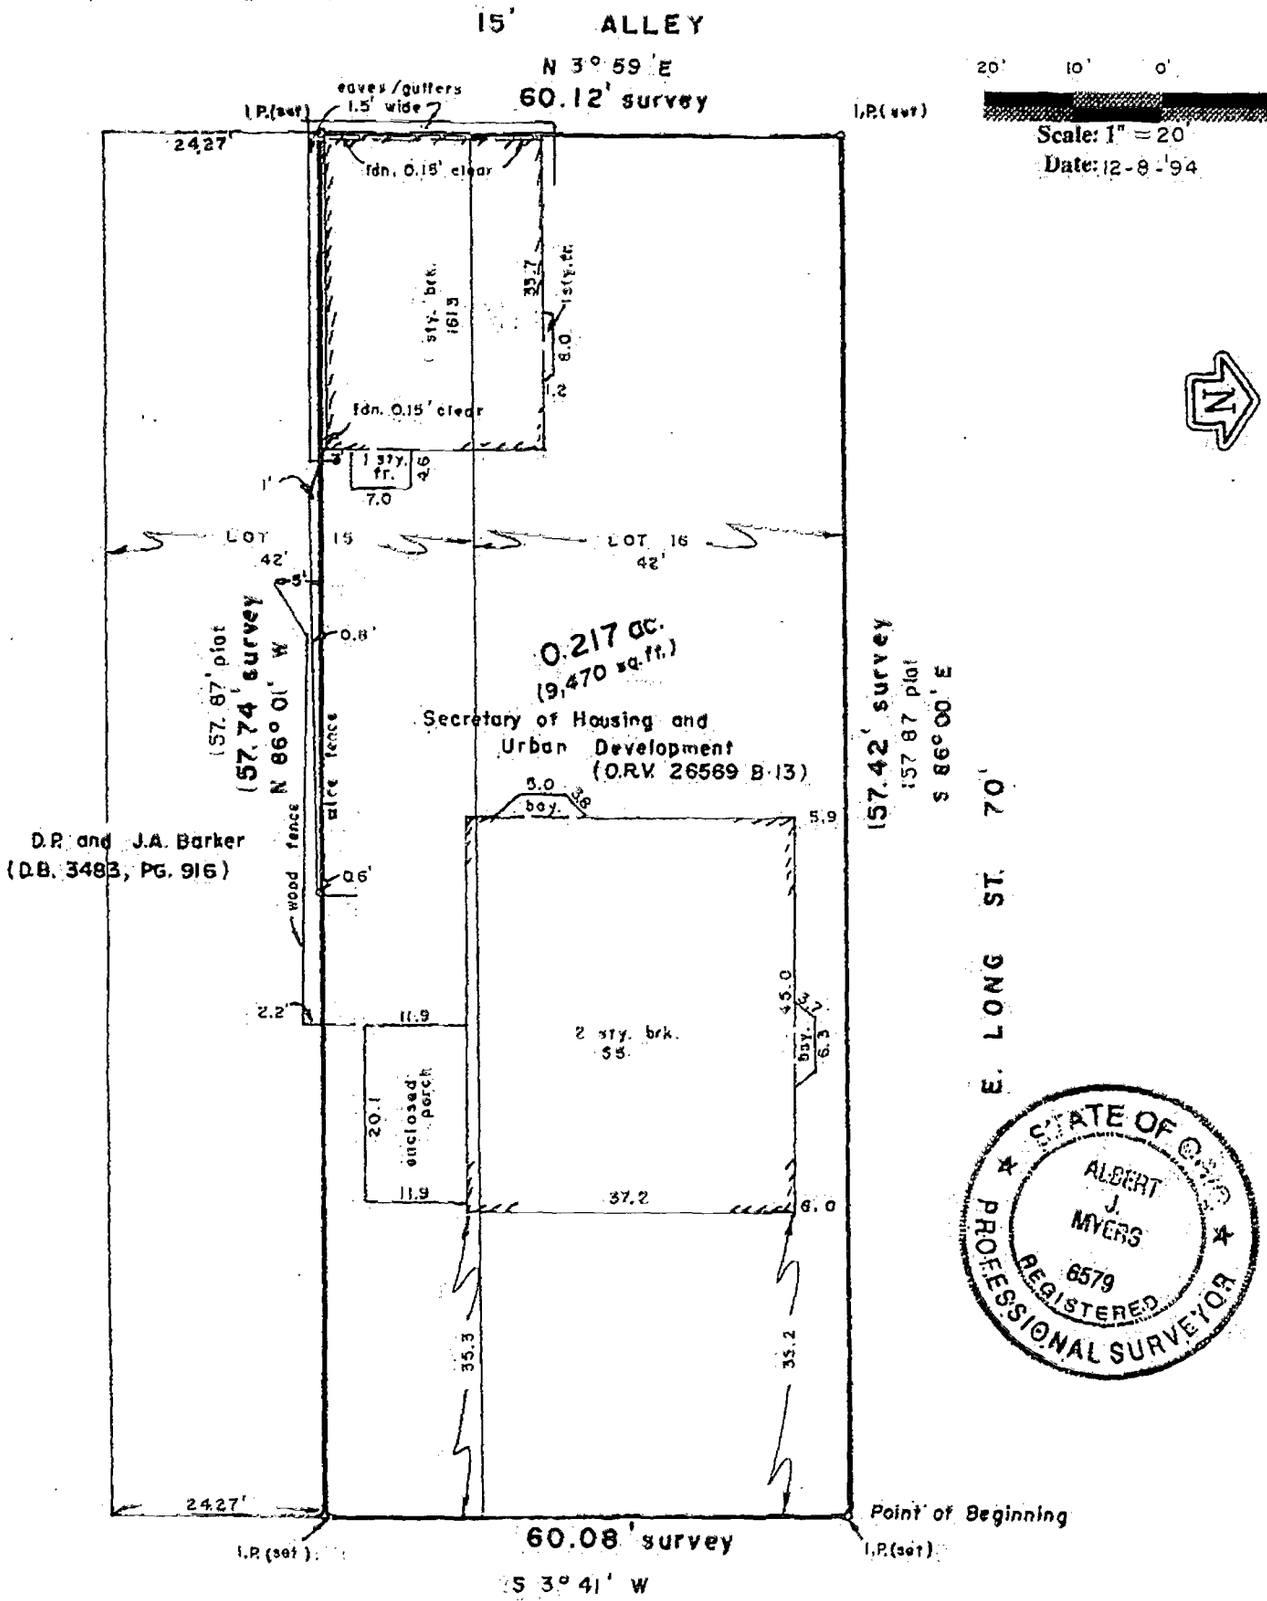

WOODLAND AVE. 60'

We hereby certify that the foregoing Boundary Survey was prepared from actual field measurements in accordance with Chapter 4733-37 Ohio Administrative Code. Iron pins set are 30"x1" O.D. with an orange plastic plug inscribed "P.S. 6579", unless otherwise noted. Basis of bearing is the south line of E. Long St. held as S 86°00'E.

Myers Surveying Co., Inc.
By _____
Professional Surveyor

Myers Order No. - 40-11/14/94	Rec.	Field	DWG	Ltr.	Ck.

11-22