Myers Surveying Company, Inc.

2740 East Main Street, Columbus 43209 (Bexley), Ohio
614-235-8677 FAX: 614-235-4559

A Boundary Survey prepared for and certified to:
Brian Brooks

Legal Description: Situated in Ohio, County of Franklin, City of Columbus, Being Part of Lots 19 and 20 Franklin Park Subdivision, Plat Book 4, Page 20

Applicant:

Posted Address: 117 Franklin Park West, Columbus, Ohio

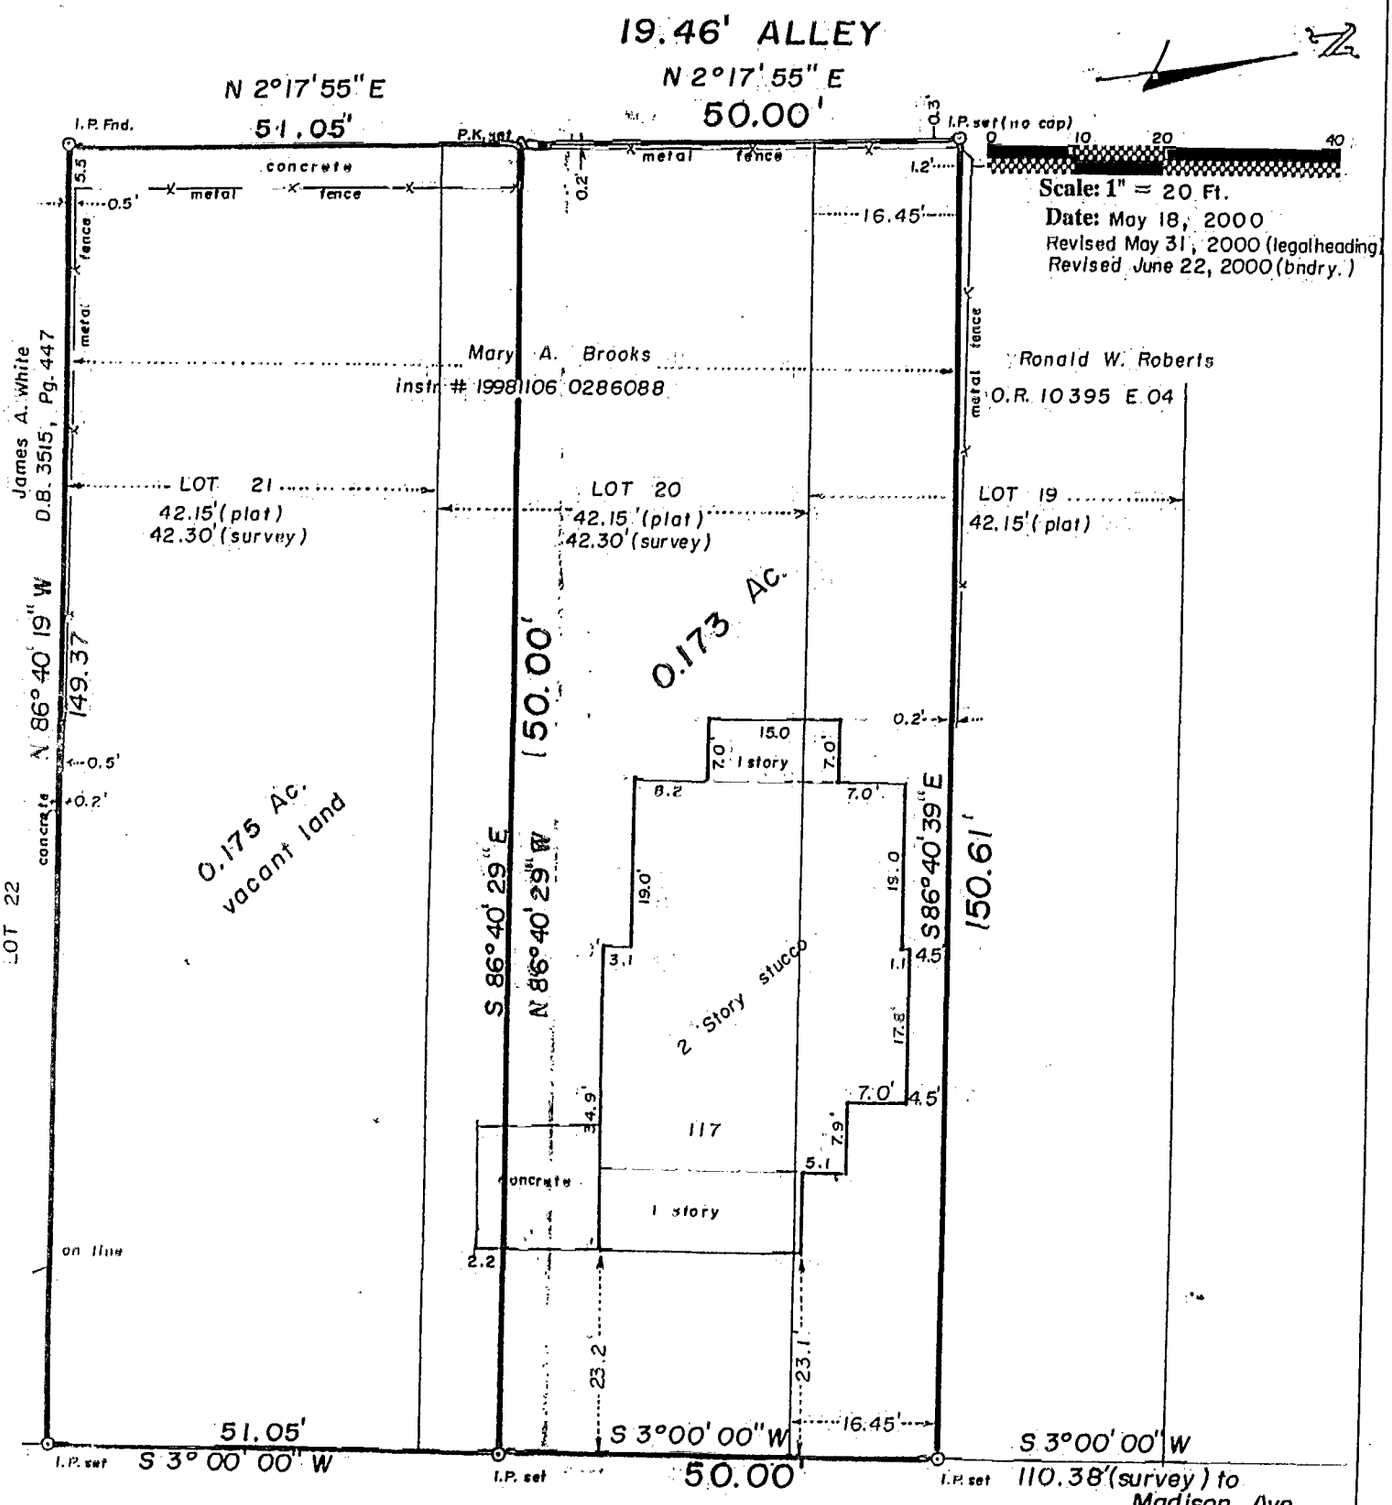

FRANKLIN PARK WEST 50'

We hereby certify that the foregoing Boundary Survey was prepared from actual field measurements in accordance with Chapter 4733-37 Ohio Administrative Code. Iron pins set are 30"x1" O.D. with an orange plastic plug inscribed "P.S. 6579", unless otherwise noted. Basis of bearing is Franklin Park West held as North 3 degrees East as scaled from City of Columbus sheet #33-4

STATE OF OHIO
JAMES L. WILLIAMS
7167
REGISTERED
PROFESSIONAL SURVEYOR

Myers Surveying Co., Inc.
By James L. Williams
Professional Surveyor

Myers Order No. - 22-04/19/72	Rec.	Field	DWG	Ltr.	Ck.