
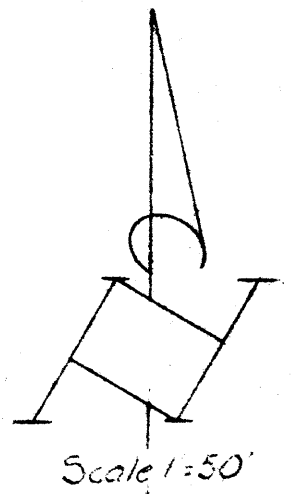


I-38

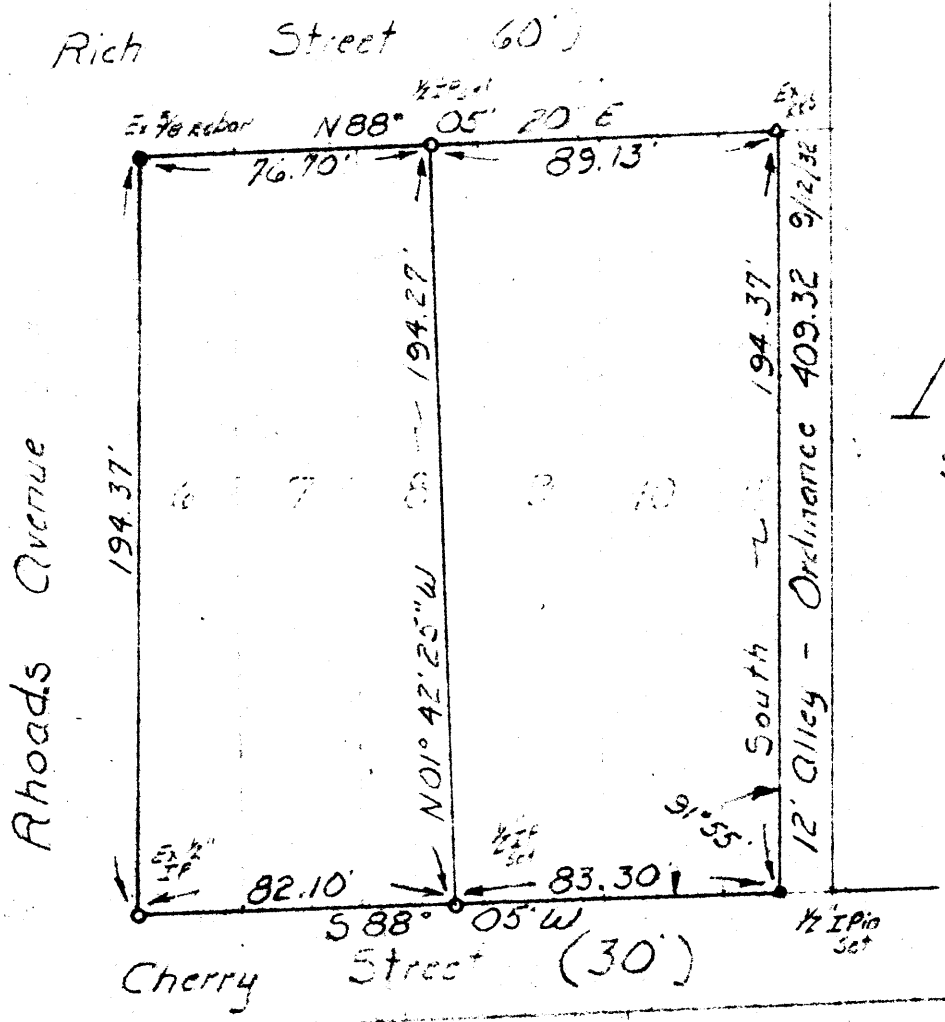


Survey of a part of Lot # 8,  
 all of Lots # 9 & 10 and Part of Lot  
 # 11 in the W.M. Collom's Subdivision,  
 Plat Book # 3 Page # 23. City of Columbus,  
 Franklin County, Ohio: for

Virgil Carter

**Louis F Haines**

354 Kessler Street  
 Groveport, Ohio 43125  
 Phone 837-2181

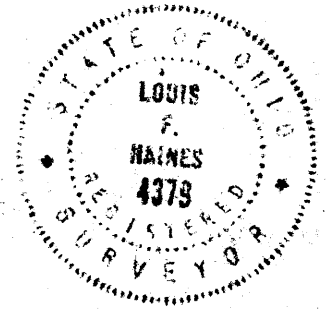

I HEREBY CERTIFY THE PLAT SHOWN HEREON  
 IS CORRECT AS SURVEYED BY US.  
 DATE: August 22, 1991  
 SIGNED: Louis F. Haines

18410 7125

