1 of 0

18435 7150
18435 7125

MYERS SURVEYING CO.

2740 East Main Street, Columbus 43209 (Bexley), Ohio

LOT 1 & PART OF LOTS 2 & 3, PARK HILL ADD'N. BEXLEY, OHIO

FOR

CHICAGO TITLE INSURANCE CO.

AND/OR

CITIZENS FEDERAL SAVINGS & LOAN ASS'N.

P.B. 18 *Page* 53
Scale 1"=60'

Franklin Co. Rec. Office
1·8·'87

NOT TO BE USED TO ERECT FENCES

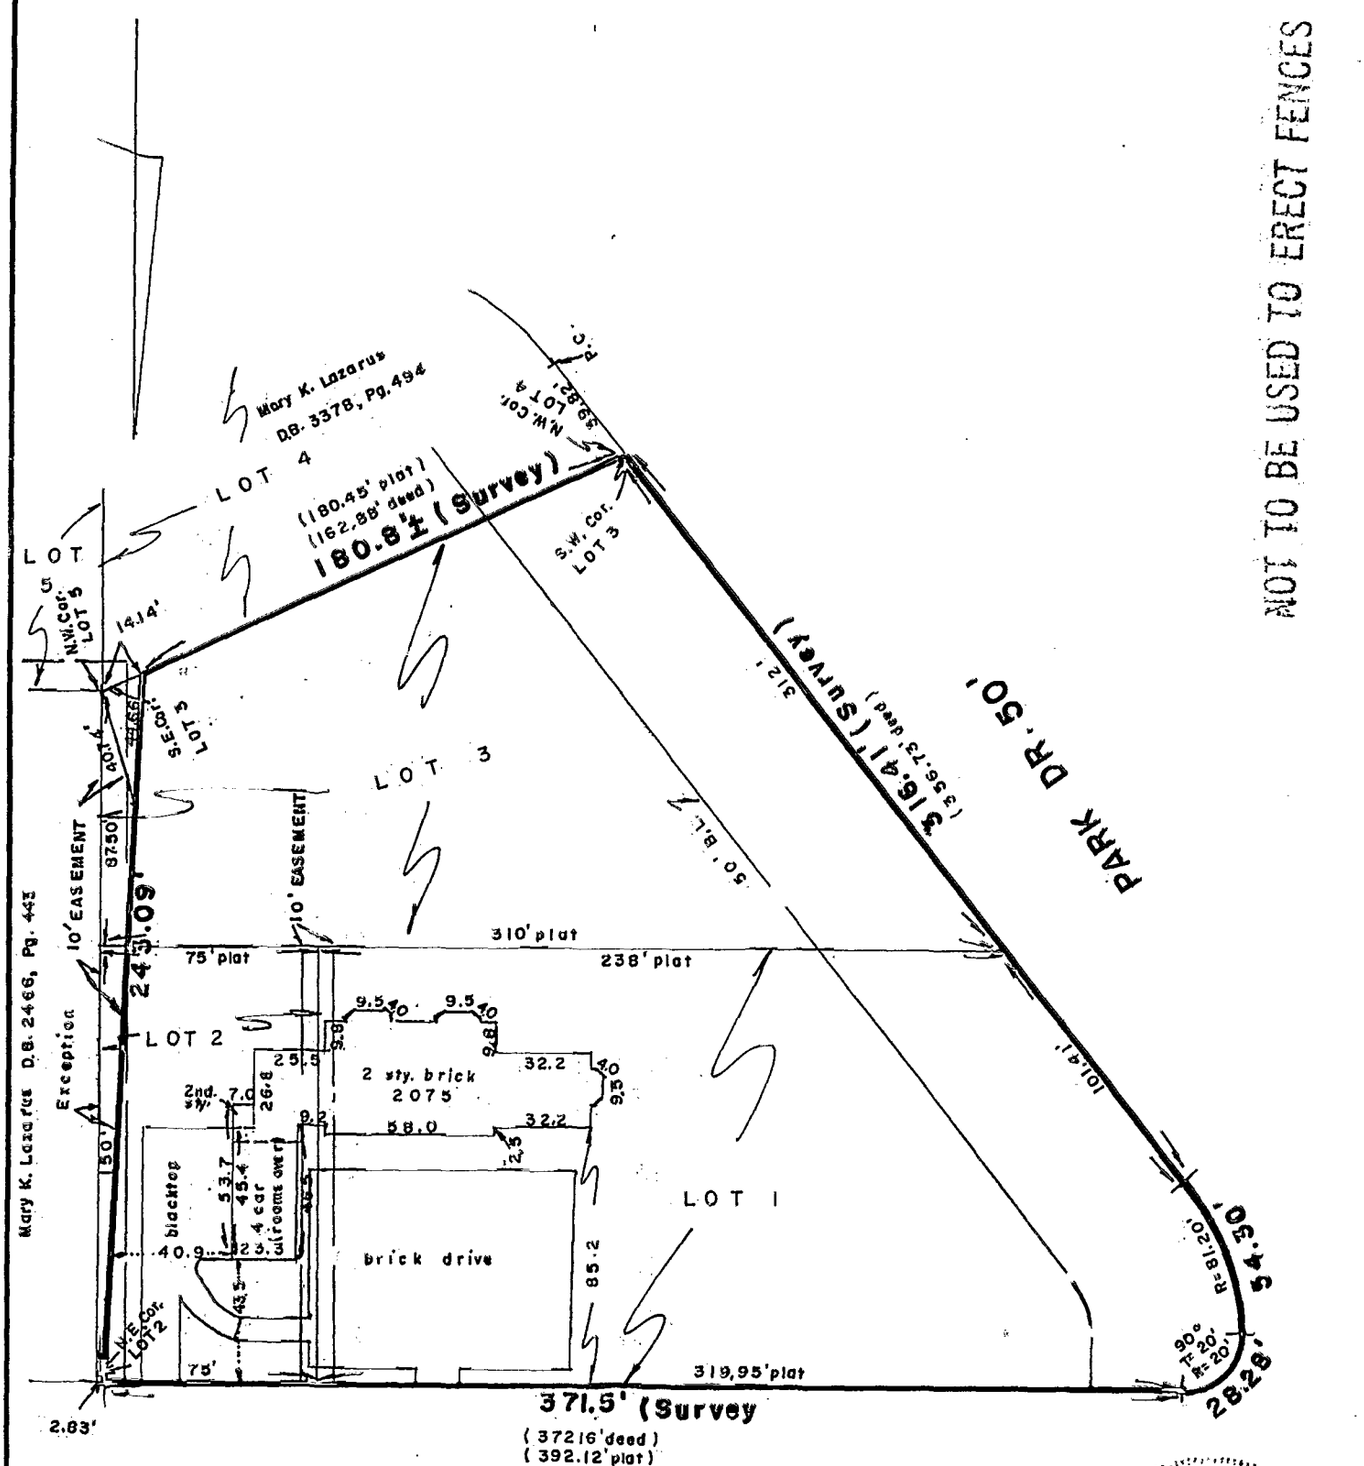

FAIR AVE. 60'

STATE OF OHIO
ALBERT D. MYERS, JR.
3352
REGISTERED SURVEYOR

We hereby certify that the foregoing plat was prepared from an actual survey of the premises. No side line of principal building is less than dimension shown. Iron pins not set unless indicated thus –0–. For Mortgage Loan & Title Insurance purposes only.

BUNDY

MYERS SURVEYING CO.

BY Albert D. Myers Jr.
Registered Surveyor

KEY BLUE PRINTS, INC. 1000H

F D L C