

2740 Eas. Main Street, Columbus 9, Ohio.

LOTS 1, 2, TR. T. W. & S. V. R. CARPENTERS' ADD. N. COLUMBUS OHIO

FOR

BRUCE M. KRESCHEK, REALTOR

Page 20

See map 30

AILEY

H.S. See map 11

497
cup

4363

















MYERS SURVEYING CO.
2740 East Main Street, Columbus 9 (Dexley), Ohio

LOTS 1, 2, T.R., T.W. & S.V.R. CARPENTER'S ADD'N. COLUMBUS OHIO

FOR

I-61


BRUCE M. KREISCHER, REALTOR

P.B. Page
Scale 1" = 20'

Franklin Co. Rec. Office

10-16-67

2 1/2 ft from p.c.
Sewer in alley 30'
49 1/2
86.0' Sewer Tap in use
ALLEY *Gas in alley*

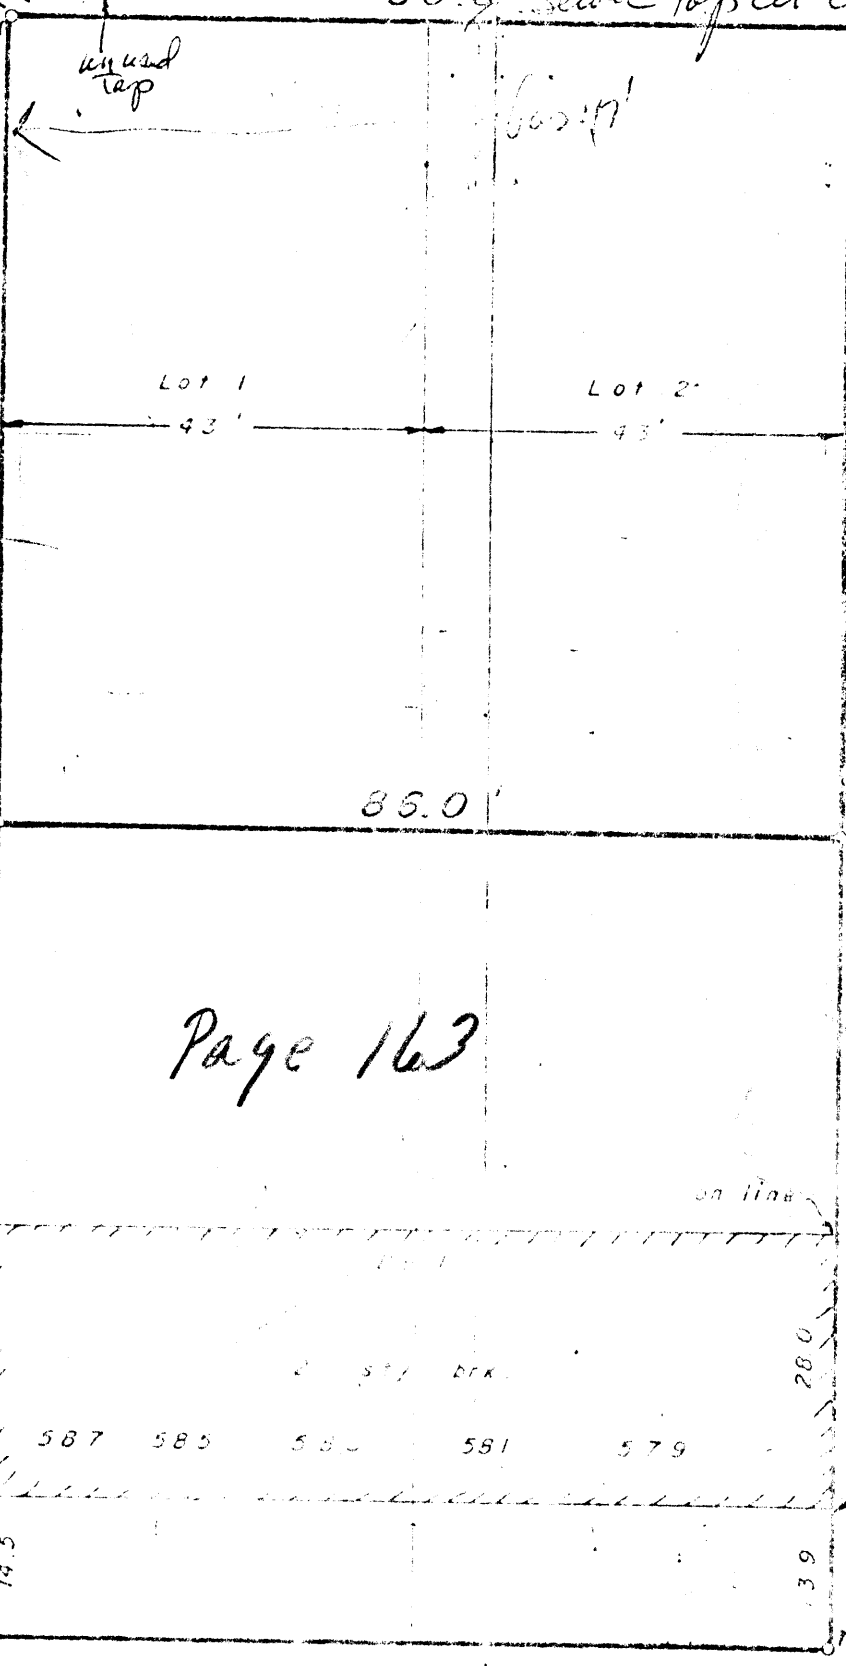

Page 163

STONE AVE. 35'

83.63'

83.65'

CARPENTER ST. 60'

We hereby certify that the foregoing plat is a true and correct copy of the actual survey of the premises. No error has been made and the area is less than shown above. This plat is correct and true. Thus -0-

MYERS SURVEYING CO.
BY *[Signature]*

MYERS SURVEYING Co.

2740 East Main Street, Columbus 9 (Daxley), Ohio

LOTS 1, 2, T.R., T.W. & S.V.R. CARPENTER'S ADD'N. COLUMBUS OHIO

FOR


I-61

BRUCE M. KREISCHER, REALTOR

P.B. Page
Scale 1" = 20'

Franklin Co. Rec. Office

10-16-'67

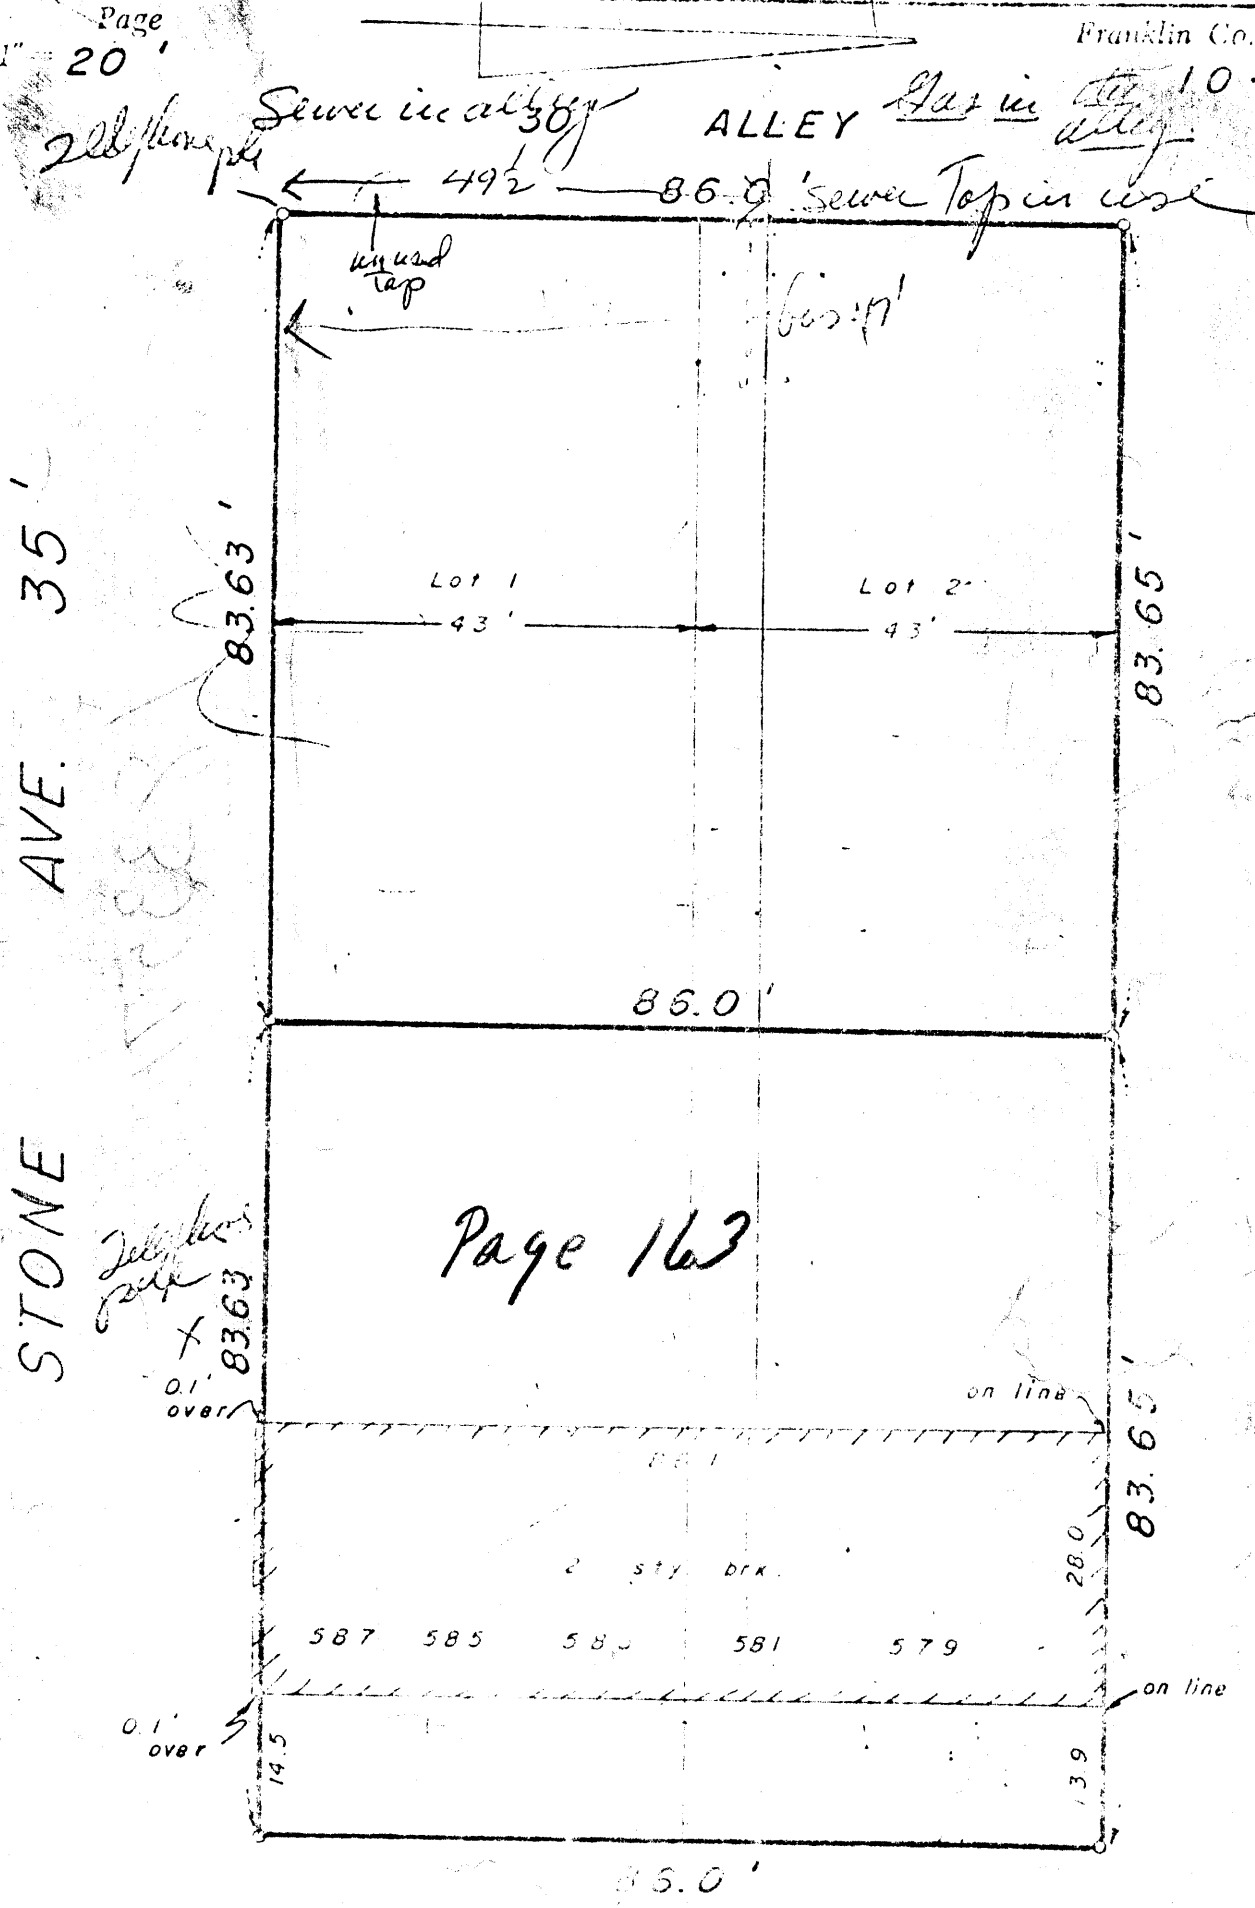

STONE AVE. 35'

Page 163

CARPENTER ST. 60'

We hereby certify that the foregoing plat is a true and correct copy of the actual survey of the premises. No side line is shown where the actual distance is less than dimension shown. Iron pins are shown where used. Thus -0-

MYERS SURVEYING CO.

BY *[Signature]*