

18335/100

MYERS SURVEYING CO.

2740 East Main Street, Columbus 43209 (Bexley), Ohio

LOT 4 & PART OF LOT 3 WAGNER & M^CCOMB'S SUB. COLUMBUS, OHIO



P.B. 4 Page 206

Scale 1"=15'

Franklin Co. Rec. Office

8 -25 -'86

Revised 9-23-'86

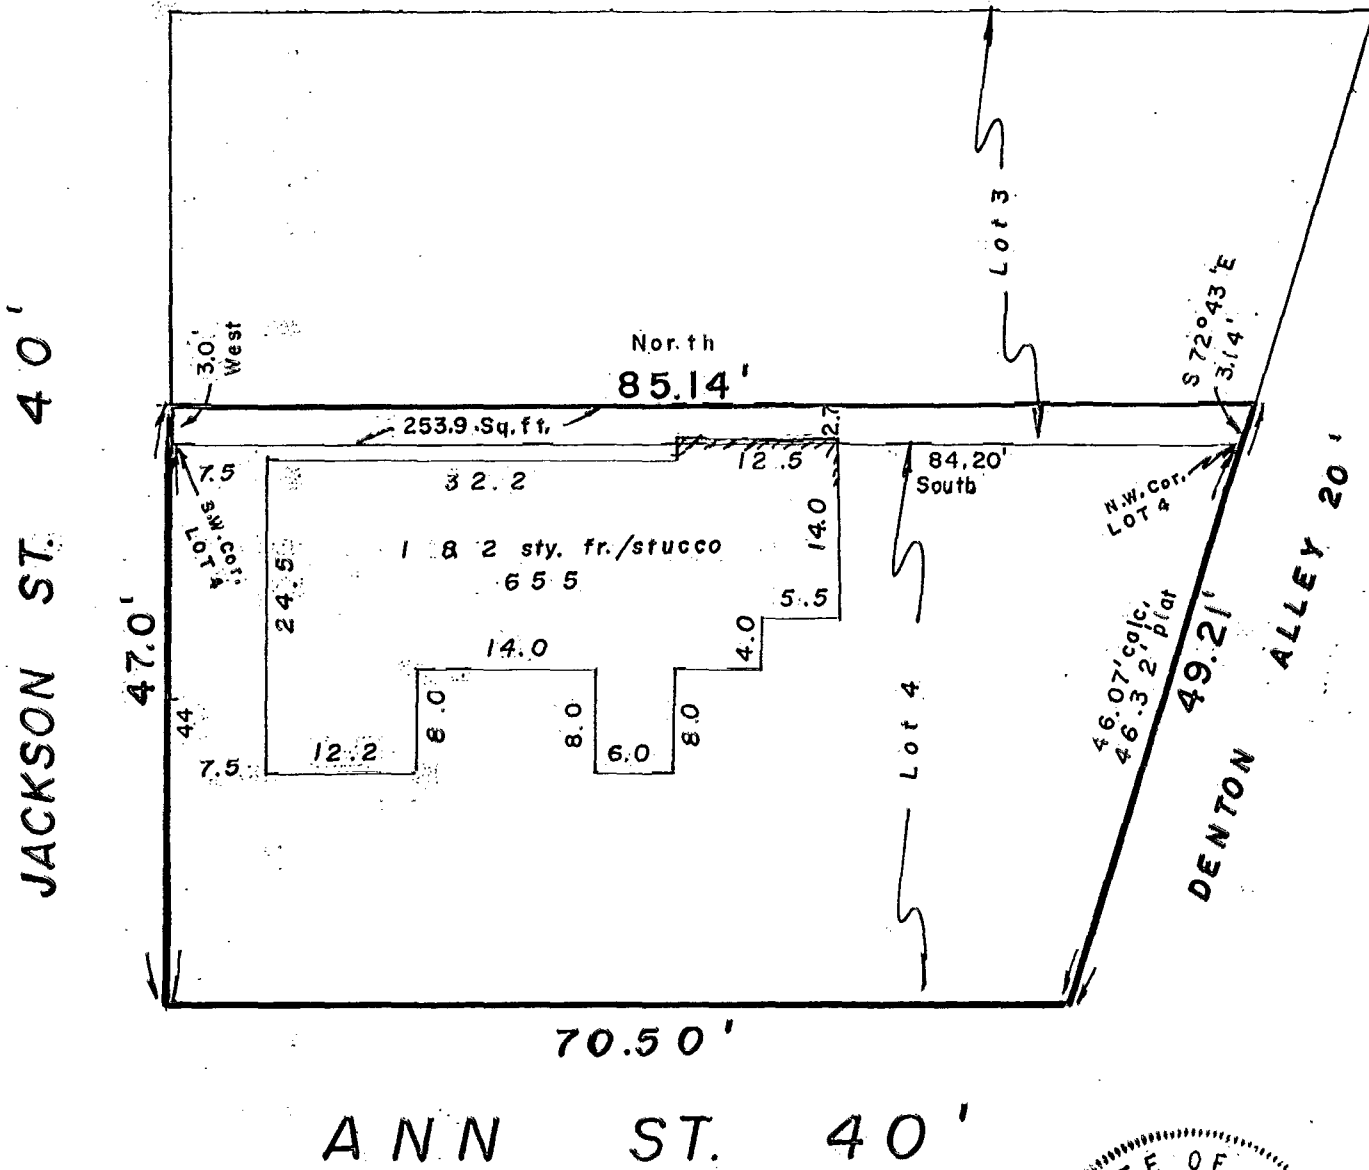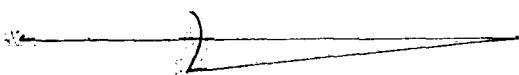

NOT TO BE USED TO ERECT FENCES

We hereby certify that the foregoing plat was prepared from an actual survey of the premises. No side line of principal building is less than dimension shown. Iron pins not set unless indicated thus: -0-. For Mortgage Loan & Title Insurance purposes only.

MYERS SURVEYING CO.

BY *Albert D. Myers, Jr.*
Registered Surveyor

