/83357100

MYERS SURVEYING CO.

2740 East Main Street, Columbus 43209 (Bexley), Ohio

.OT 181 SWAYNE'S ADD'N. COLUMBUS, OHIO

FOR

J 11

BRUCE MURRAY

P.B. 2 Page 35
Scale 1" = 20'

Franklin Co. Rec. Office
6 · 9 · '81

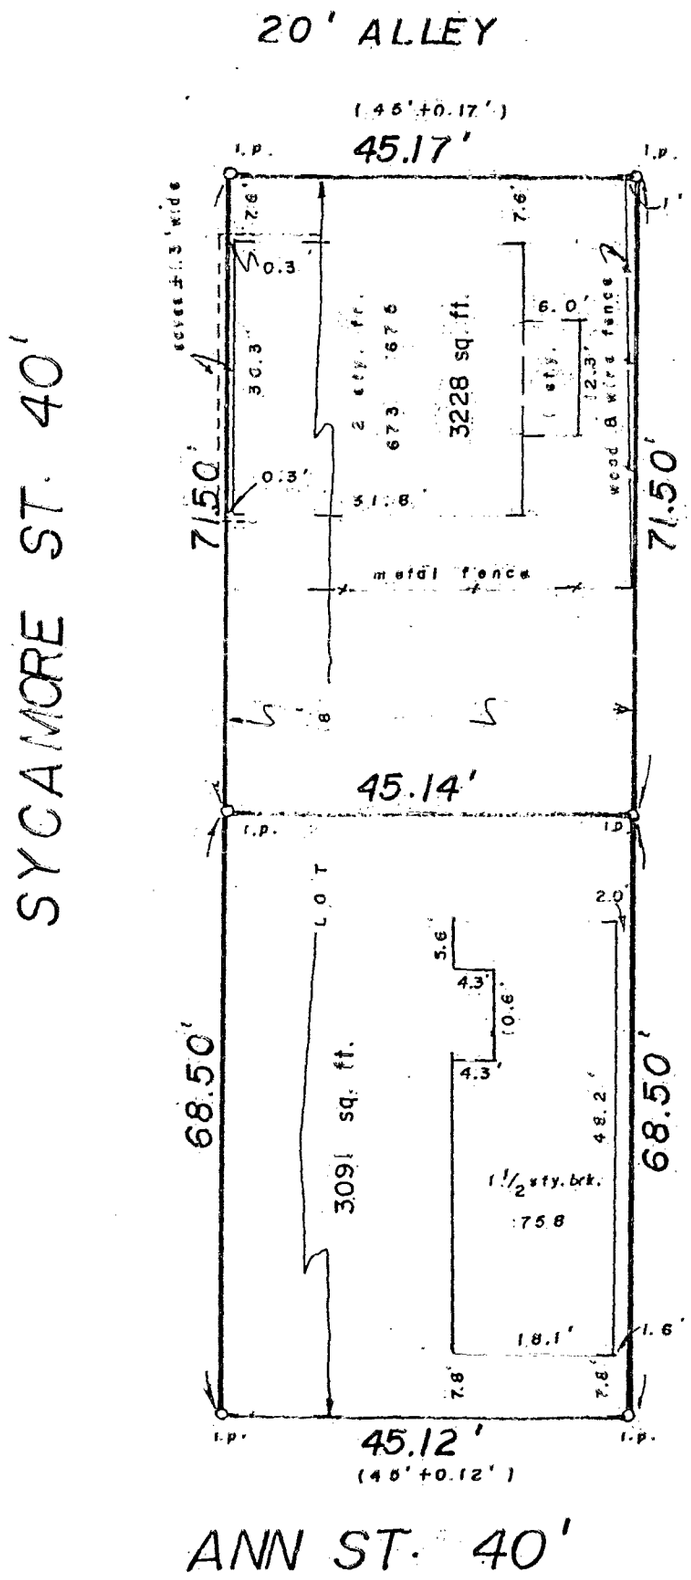

STATE OF OHIO
ALBERT D. MYERS, JR.
3357
REGISTERED SURVEYOR

We hereby certify that the foregoing plat was prepared from an actual survey of the premises. No side line of principal building is less than dimension shown. Iron pins not set unless indicated thus —0—.

MYERS SURVEYING CO.
BY Albert D. Myers Jr.
Registered Surveyor

F D L C