Myers Surveying Company, Inc.

2740 East Main Street, Columbus 43209 (Bexley), Ohio
614-235-8677 FAX: 614-235-4559

A Boundary Survey prepared for and certified to:
American Mortgage Solutions

Legal Description: Situated in Ohio, County of Franklin, City of Columbus, Being Lot 372 Blesch & Kremer's Sub., Plat Book 4, Page 306

Applicant:

Posted Address: 541 Siebert/1067 Wager, Columbus, Ohio

F.E.M.A. Flood Zone Designation: Flood Zone "X" as per F.I.R.M. 390170 0255 G

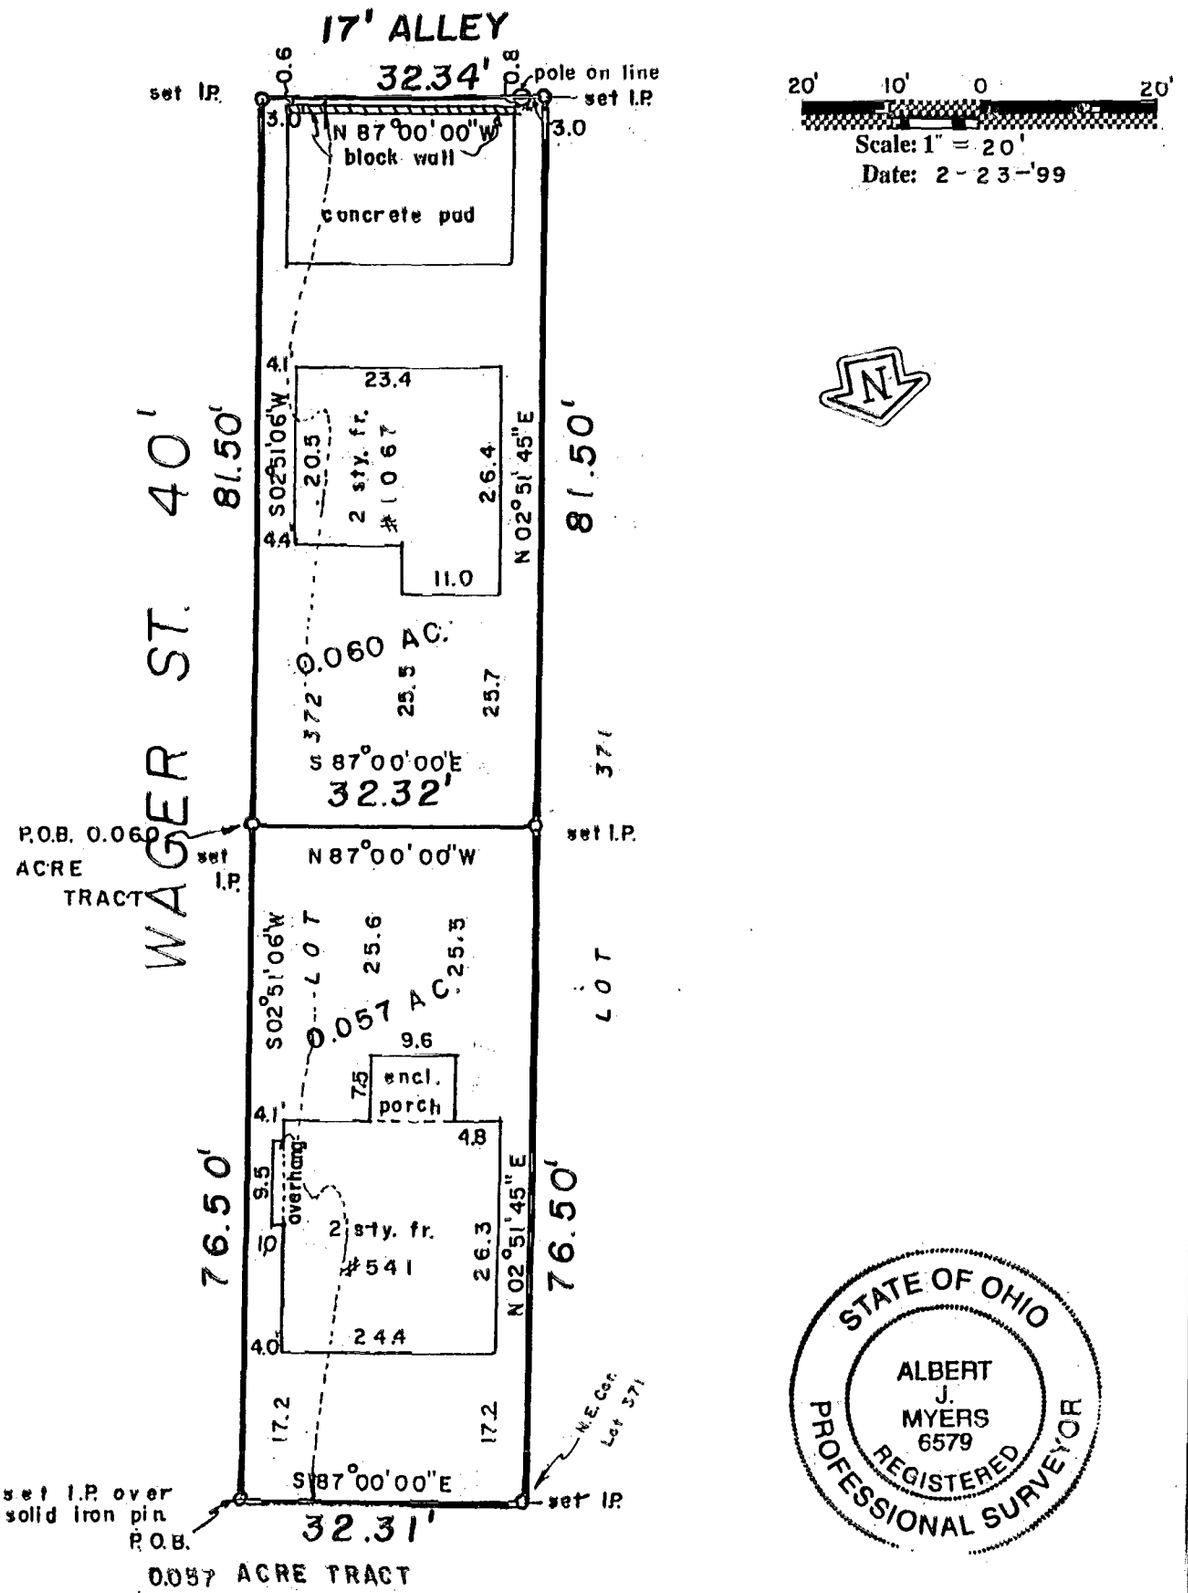

20' 10' 0 20'
Scale: 1" = 20'
Date: 2-23-'99

STATE OF OHIO
ALBERT J. MYERS 6579
REGISTERED PROFESSIONAL SURVEYOR

We hereby certify that the foregoing Boundary Survey was prepared from actual field measurements in accordance with Chapter 4733-37 Ohio Administrative Code. Iron pins set are 30"x1" O.D. with an orange plastic plug inscribed "P.S. 6579", unless otherwise noted. Basis of bearings is the south line of Siebert St. as S. 87 degrees 00 minutes East as scaled from City of Columbus Engineer's Maps.

LS99-025
Myers Surveying Co., Inc.
By *Professional Surveyor*

83 107 075

Myers Order No. - 9-08/17/98 | Rec. bg | Field AOM III / AJM | DWG AOM III | Ltr. AOM III | Ck. mf