"EXHIBIT A"

Myers Surveying Company, Inc.

2740 East Main Street, Columbus 43209 (Bexley), Ohio
614-235-8677 FAX: 614-235-4559

A Boundary Survey prepared for and certified to:
Columbus (Ohio) Teacher's Federal Credit Union

Legal Description: Being 1119 Square Feet, Part of a 0.183 acre tract(ORV 13304, Page A 11) Recorders Office, Franklin County, Ohio.

0 10 20 40
Scale: 1" = 20'
Date: 11·22·91

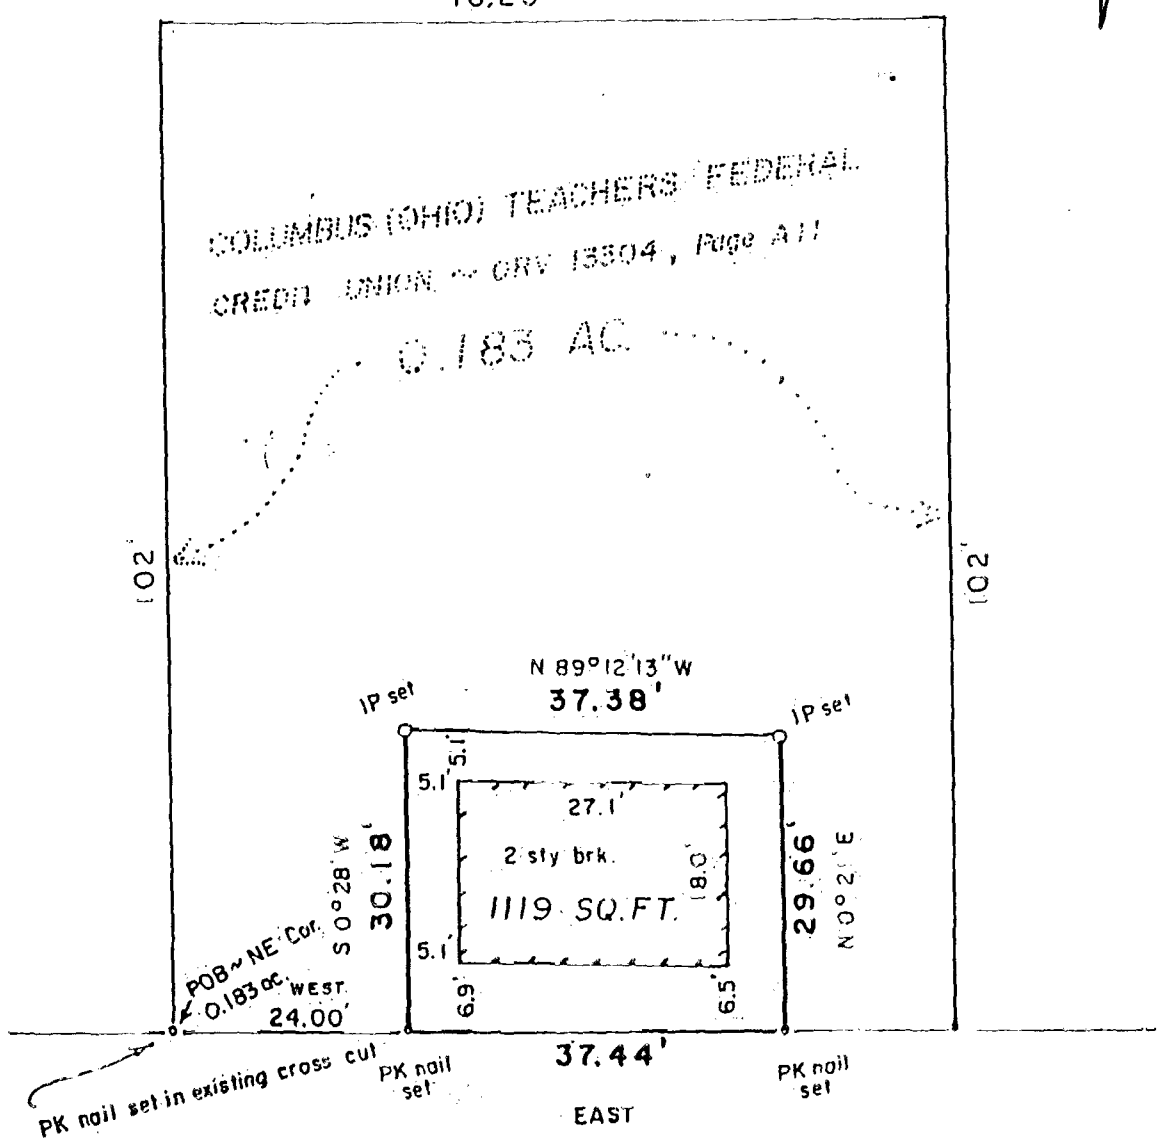

I hereby certify that the foregoing Boundary Survey was prepared from actual field measurements in accordance with Chapter 4733-37 Ohio Administrative Code. Iron pins are 30"x1" O.D. with an orange plastic plug inscribed "P.S. 6579", unless otherwise noted. Basis of bearing is the south line of East Livingston Avenue assumed

Myers Surveying Co., Inc.
By Joseph P. Myers
Professional Surveyor

Order No. - 35-91-10-08	Rec.	Field	DWG	Ltr.	Ck.