

183107100

MYERS SURVEYING CO.

2740 East Main Street, Columbus 9 (Bexley), Ohio

BEING THE NORTH 1/2 OF LOT 16, BORN & JENNER'S AMD. ADD'N
COLUMBUS, OHIO


FOR

PAT PHILLIPS, REALTOR

P.B. 1 Page 175
Scale 1" = 20'

Franklin Co. Rec. Of
9-24-'71

Handwritten: 18

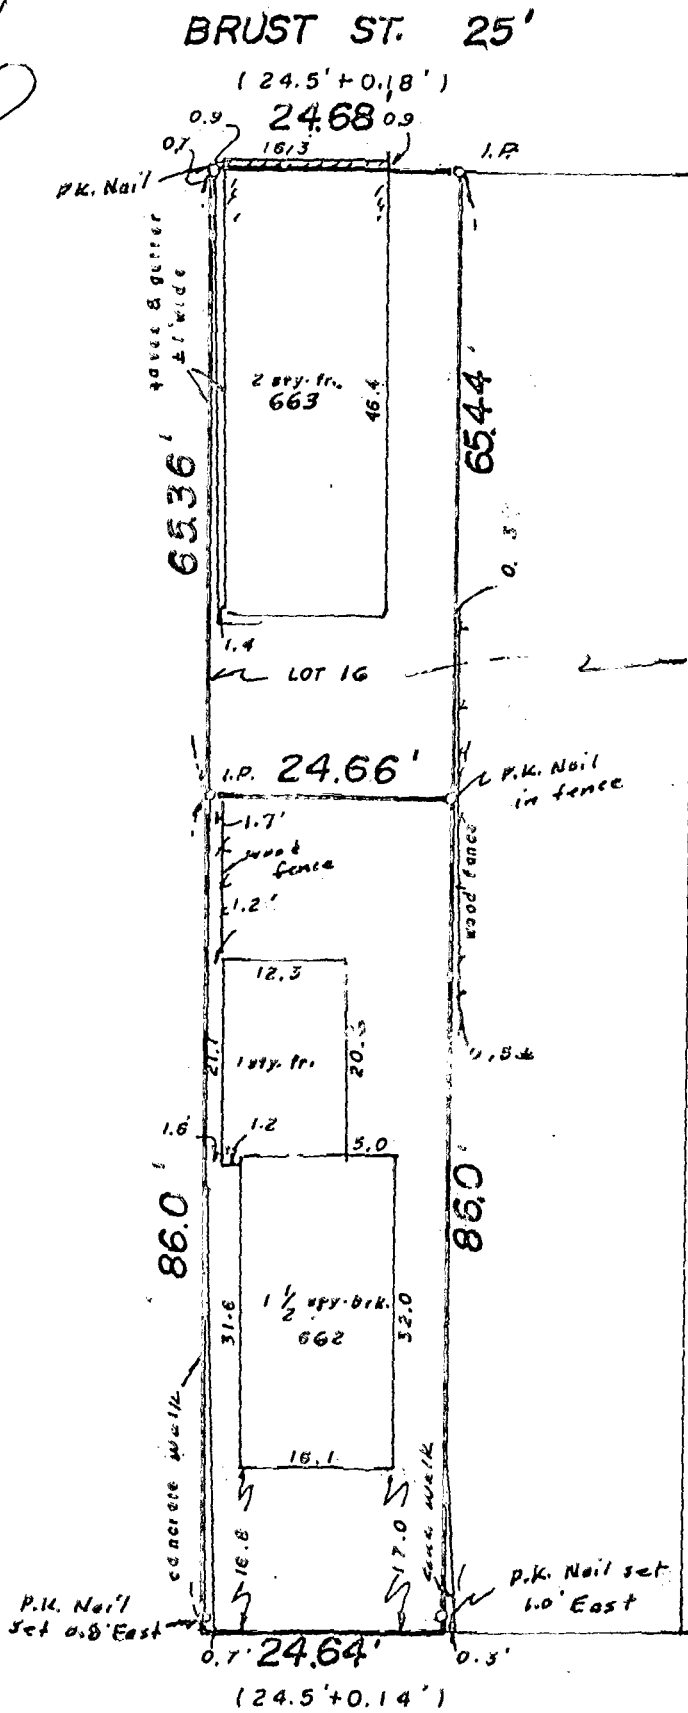

S. GRANT AVE 50'

We hereby certify that the foregoing plat was prepared from an actual survey of the premises. No side line of principal building is less than dimension shown. Iron pins not set unless indicated thus -0-

MYERS SURVEYING CO.
By *[Signature]*
Registered Surveyor