

J-16

J-16

ALLEY 15'

ALLEY 10.6'


LOT NO. 47

LOT NO. 48

RESIDENCE

BEECH ST. 20'

SYCAMORE ST 60'

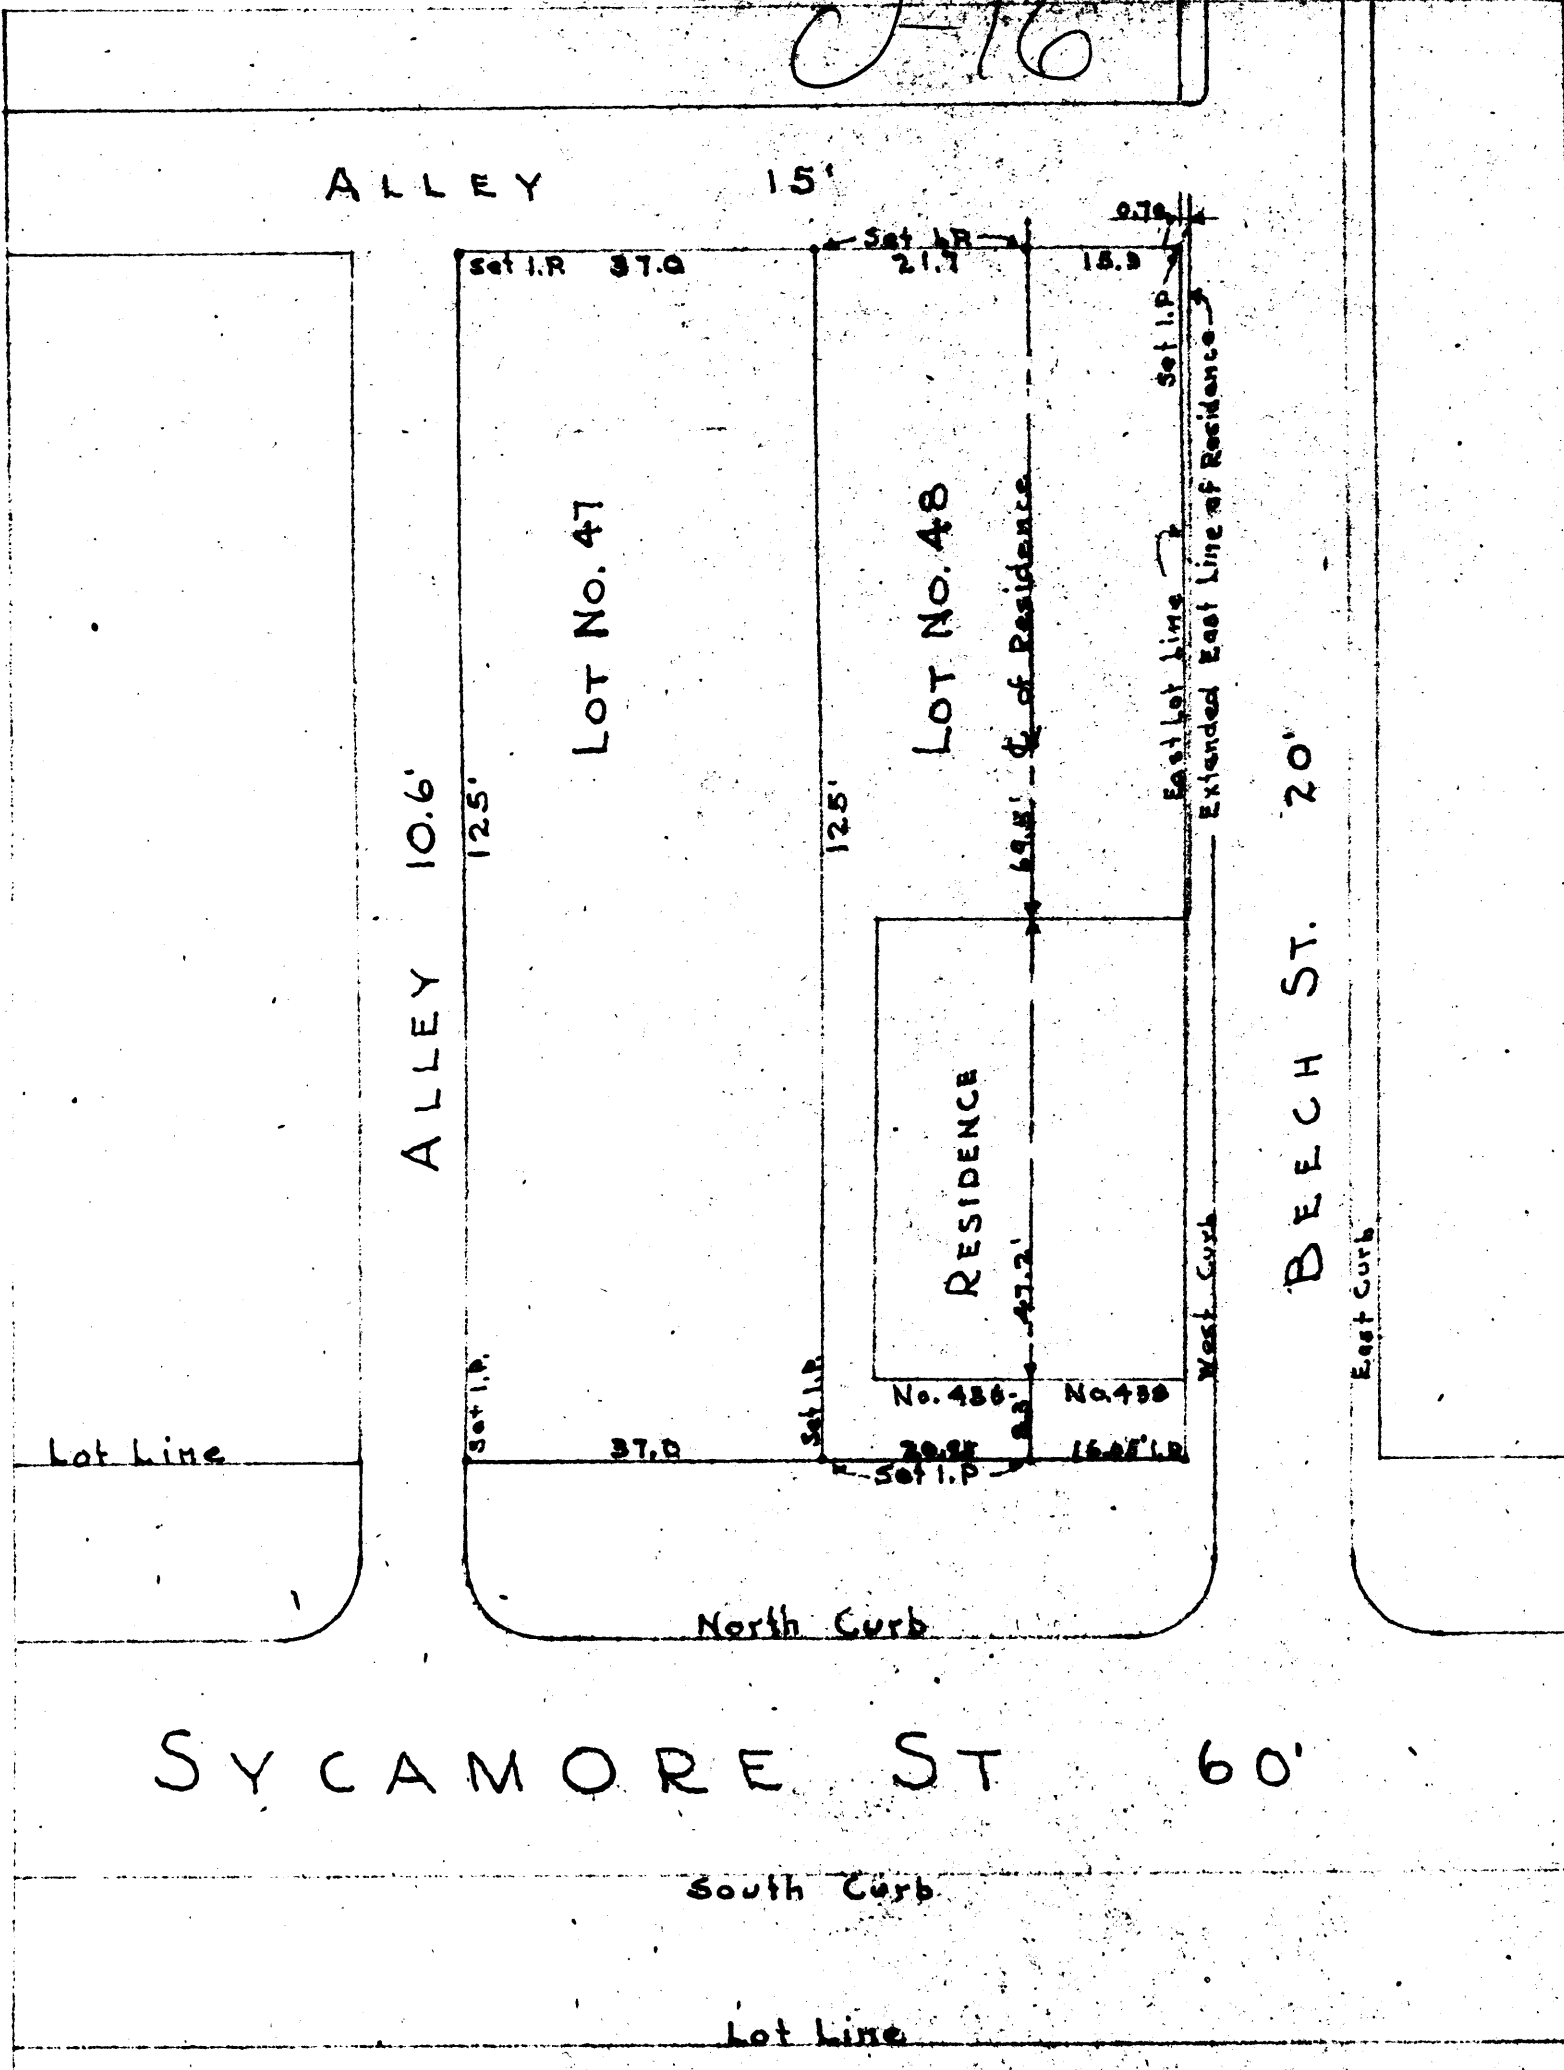

SURVEY for REINHARD MERZ & IDA DEAN -
 To ESTABLISH CORNERS OF LOTS No. 47 & 48 - AND $\frac{1}{2}$ OF RESIDENCE -
 By H.C. McCall - Registered Surveyor - 28 Beckley Place - Columbus 1 O.
 May 25 - 1951
 Scale - 1" = 20'

183107100