
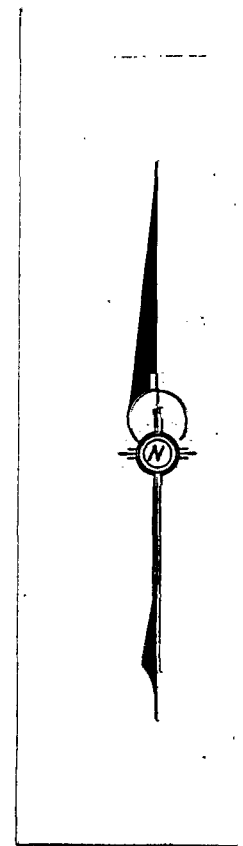


GILBERT STREET 50'

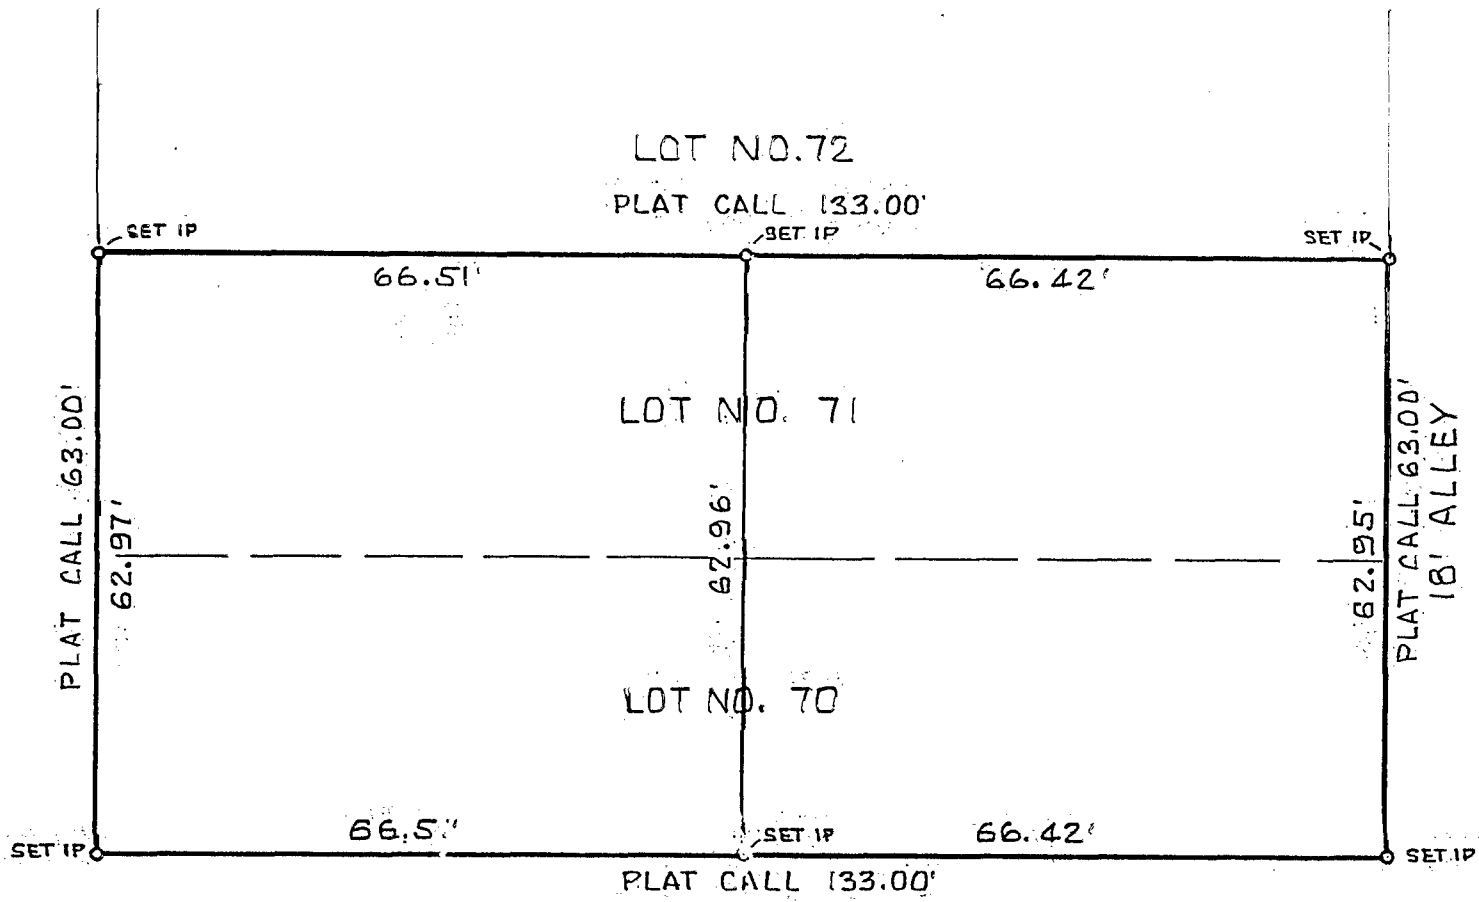

SYCAMORE STREET 50'

DIMENSIONS ARE BY SURVEY, JULY, 1987

THE THOMAS ENGINEERING & SURVEYING CO.
SCALE 1"=20' 838-87

PLAT OF DIVISION
OF LOTS 70 & 71 CLAIRMONT ADD.
P85 P180 & 181 R.O.F.C.O.
FOR
STEPHEN D. MITCHELL ATTY

Robert Math
REGISTERED SURVEYOR #4138

8335 7/00