

EVANS & MECHWART


 124171014, 124171015

0-110-H

SURVEY OF ACREAGE PARCELS

V.M.S. Survey #6366, Washington Twp., Franklin Co., Ohio

SCALE 1" = 100' o = Iron pin June, 1955 DEED BOOK _____ PAGE _____

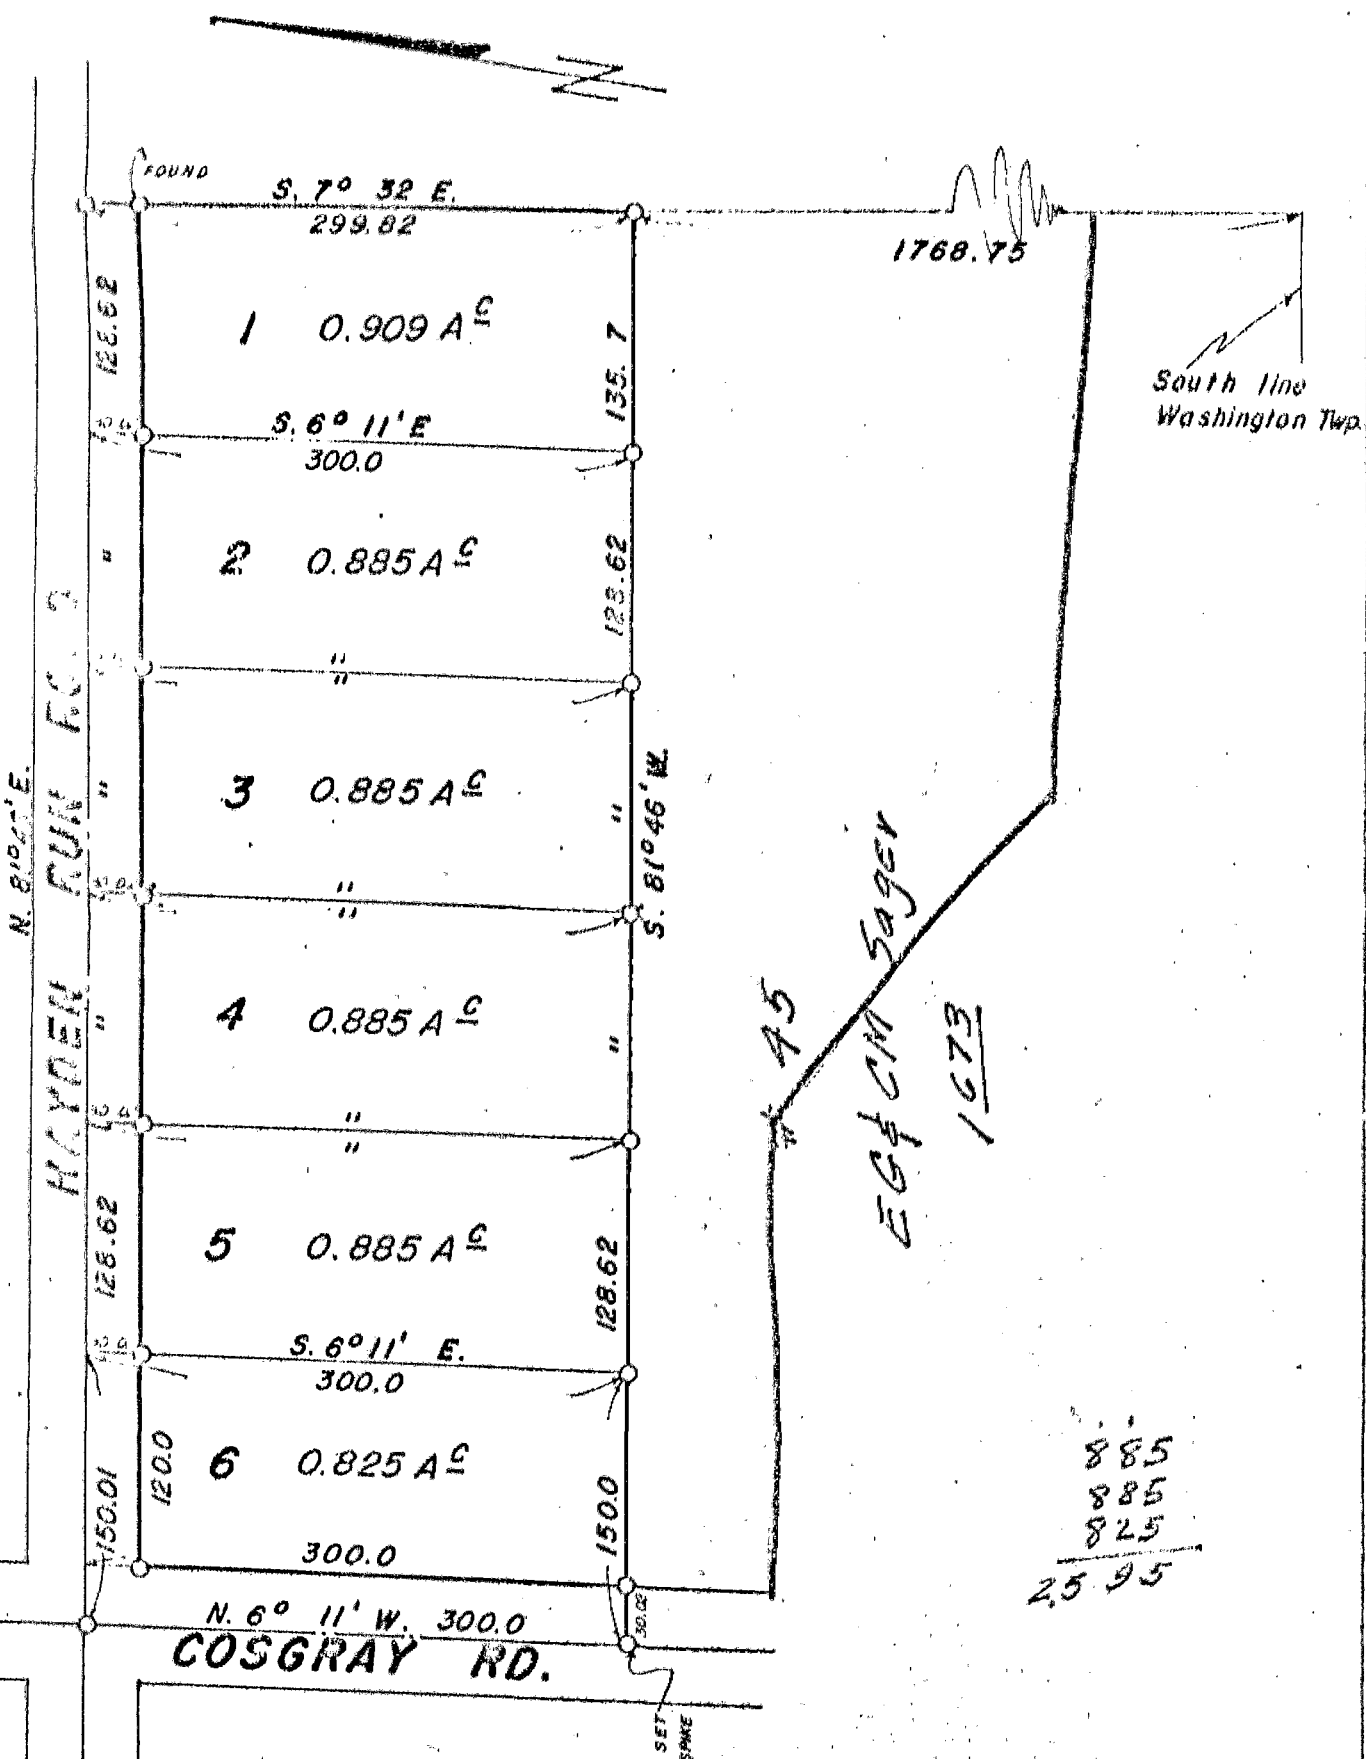

We hereby certify that the foregoing plat was prepared from an actual survey of the premises and shows the location of the boundaries.

EVANS & MECHWART

BY _____

[Signature]
 Registered Surveyor # 483