

183607075


J-39

THE GUARANTEE, TITLE & TRUST COMPANY

City of Columbus, Ohio

Schiller St, ALLEY 20'

Scale 1" = 20'
October 11, 1924

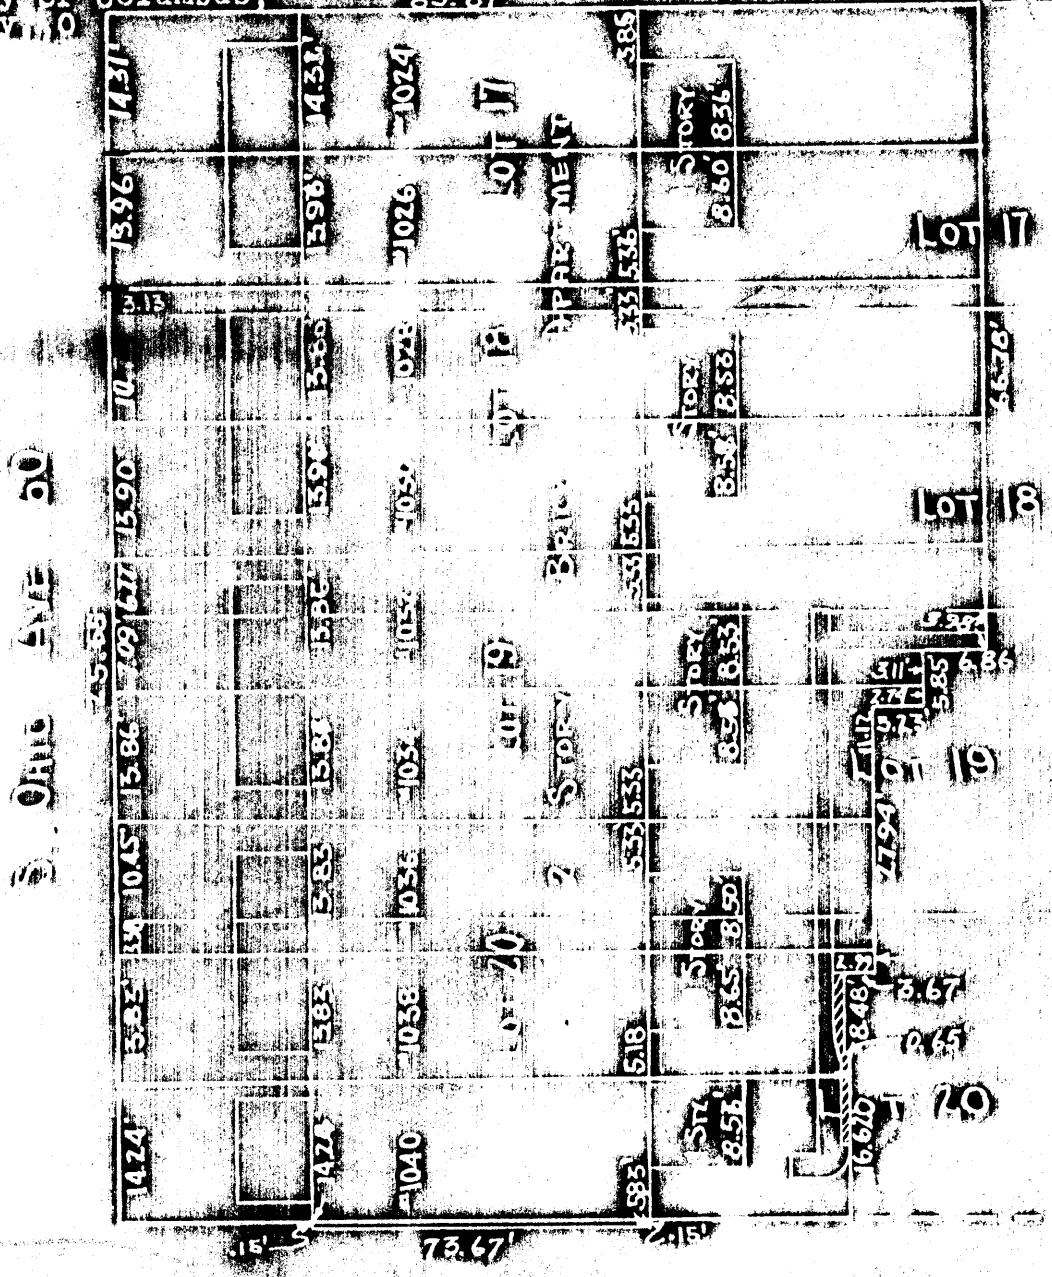

We hereby certify that the foregoing survey and drawing was made for and at the instance of The Guarantee, Title & Trust Company, Columbus, Ohio and that there are no encroachments on the property and that the buildings are entirely within the lot lines, except encroachments on Whittier Street as shown.

Pool Original

THE THOMAS ENGINEERING & SURVEYING COMPANY
Harry B. White
 Registered Engineer & Surveyor

J-39