

183607100

MYERS SURVEYING CO.


2740 East Main Street, Columbus 43209 (Bexley), Ohio.

PART OF LOT 252 OAKWOODS ADD'N. EAST COLUMBUS, OHIO

J. THOMAS MEEKS & SARAH J. MEEKS

P.B. 5 Page 152

Franklin Co. Rec. Office
3.2.90

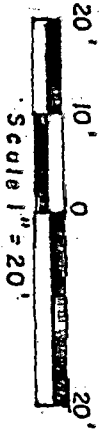


ROY ALLEY 14'


Revised 3.8.90
(split)



E. FULTON ST. 60'

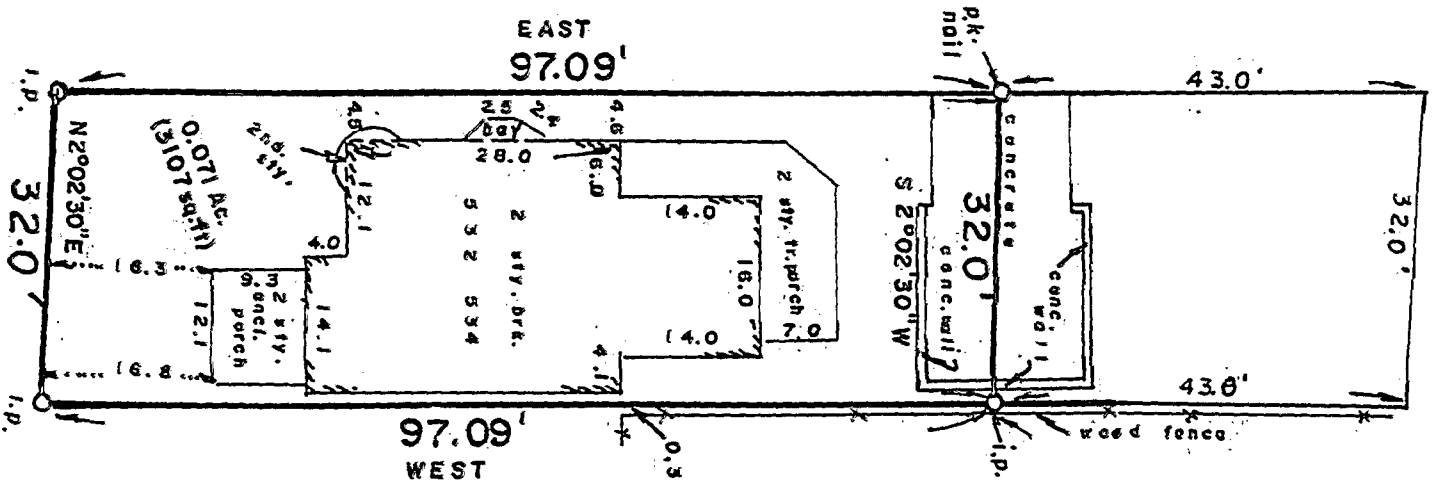

LINWOOD AVE. 50'

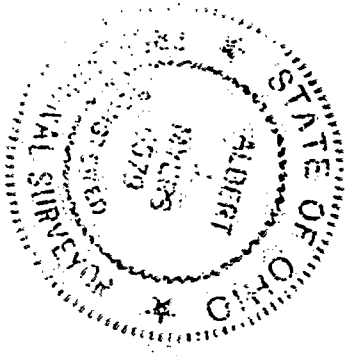

We hereby certify that the foregoing plat was prepared from an actual survey of the premises. Iron pins set are 30" x 1" O.D. with an orange plastic caps inscribed "P.S. 6579". Basis of bearings is the southerly line of East Fulton Street assumed East.

MYERS SURVEYING CO.

BY *Albert Myers*
Registered Surveyor

4-3
N
W