


84357075

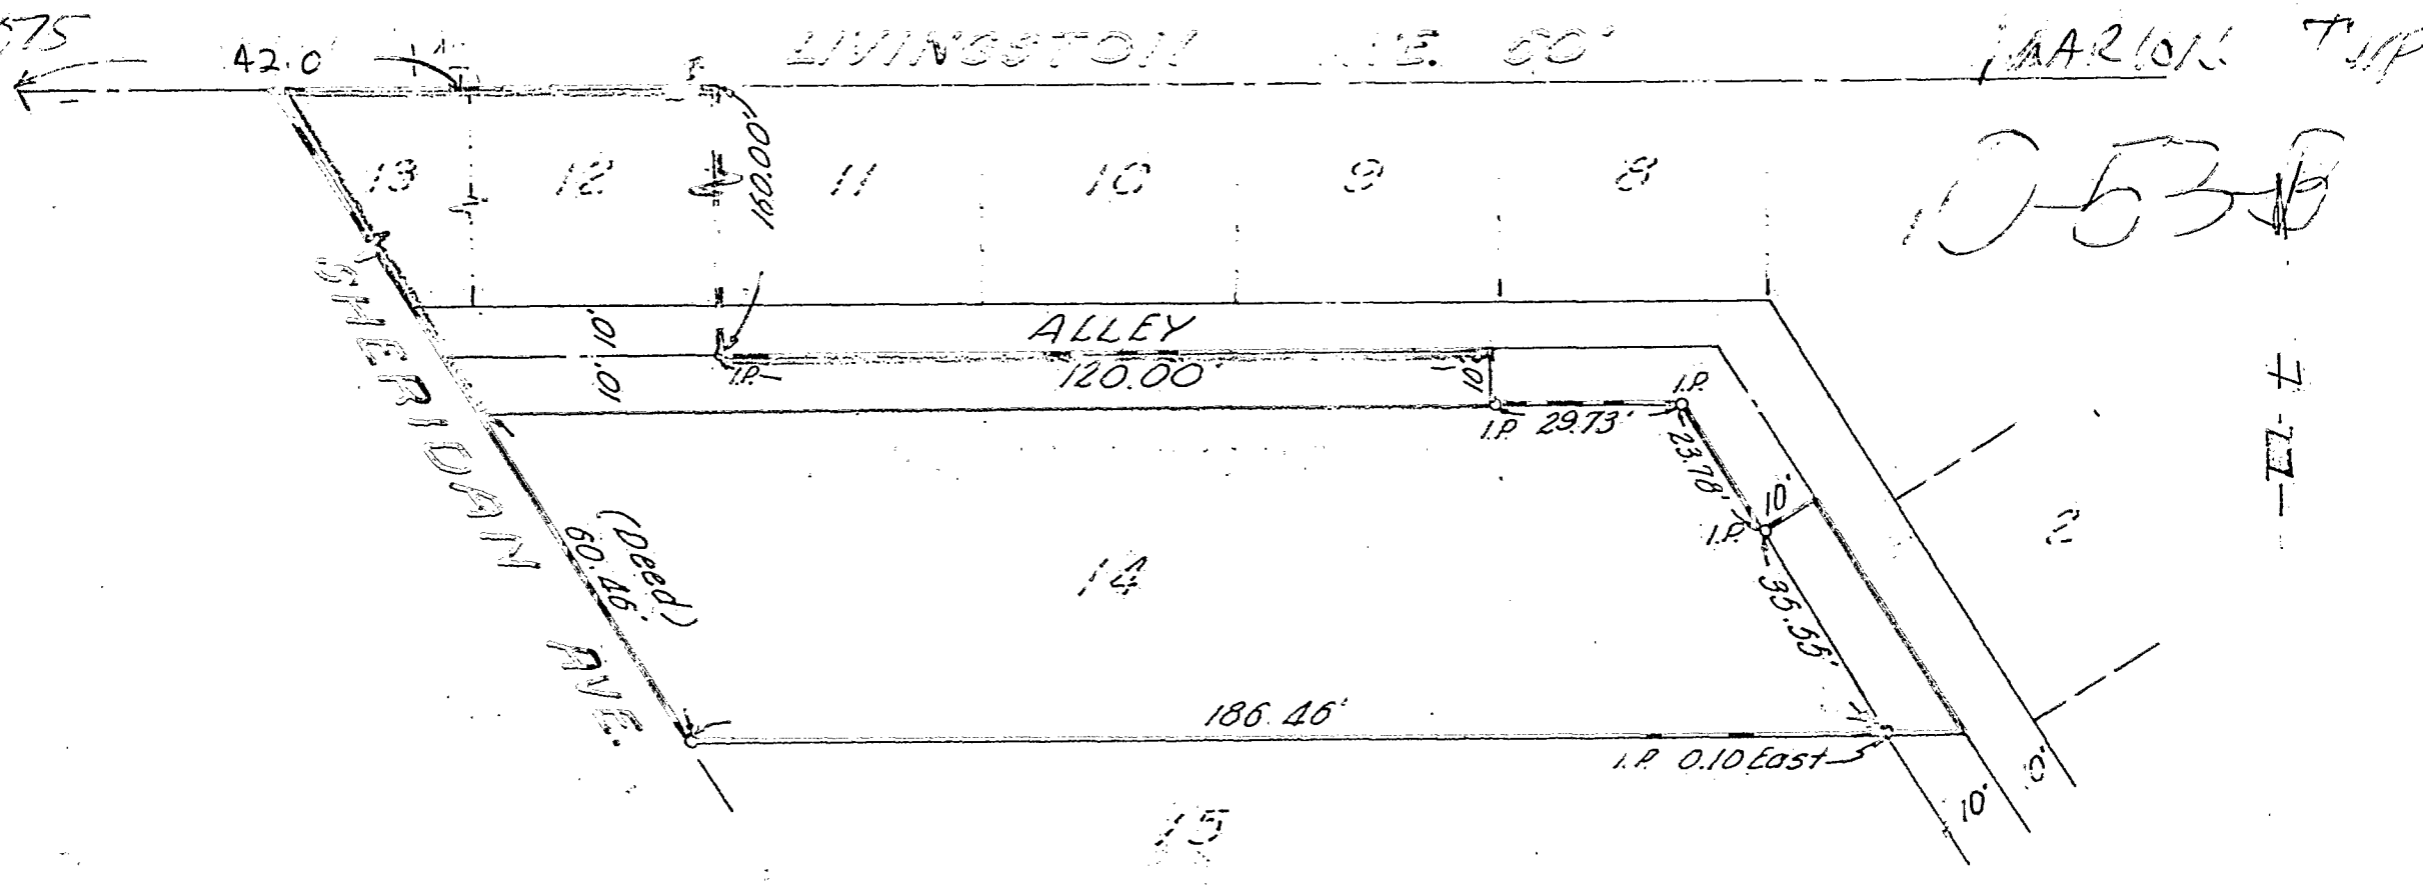

SURVEY OF
 PT OF LOT NO. 1, EDWARD LIVINGSTON HEIRS PART.
 HALF SEC. 34, SEC. 24, T-5, R-22, REFUGEE LANDS
 CITY OF COLUMBUS, FRANKLIN CO, OHIO

LLOYD GAETZ
 SCALE: 1"=30' OCT. 1967
 THE JENNINGS-LAWRENCE CO.
 Civil Engineers and Surveyors
 555 Buttes Avenue
 Columbus 15, Ohio.

B. Ly T. Underwood
 Registered Surveyor

2040 120 129 109 S LIVINGSTON AVE 1967 0532 003