PLAT OF
EMILY P. BENUA PROPERTY
COLLEGE AVENUE, MARION TOWNSHIP
FRANKLIN COUNTY, COLUMBUS, OHIO

SCALE 1" = 40' DATE 8-16-65 PLAT BOOK — PAGE — DEED BOOK 1077 PAGE 1
1773 52

o Designates Iron Pin Set

o " I P Found

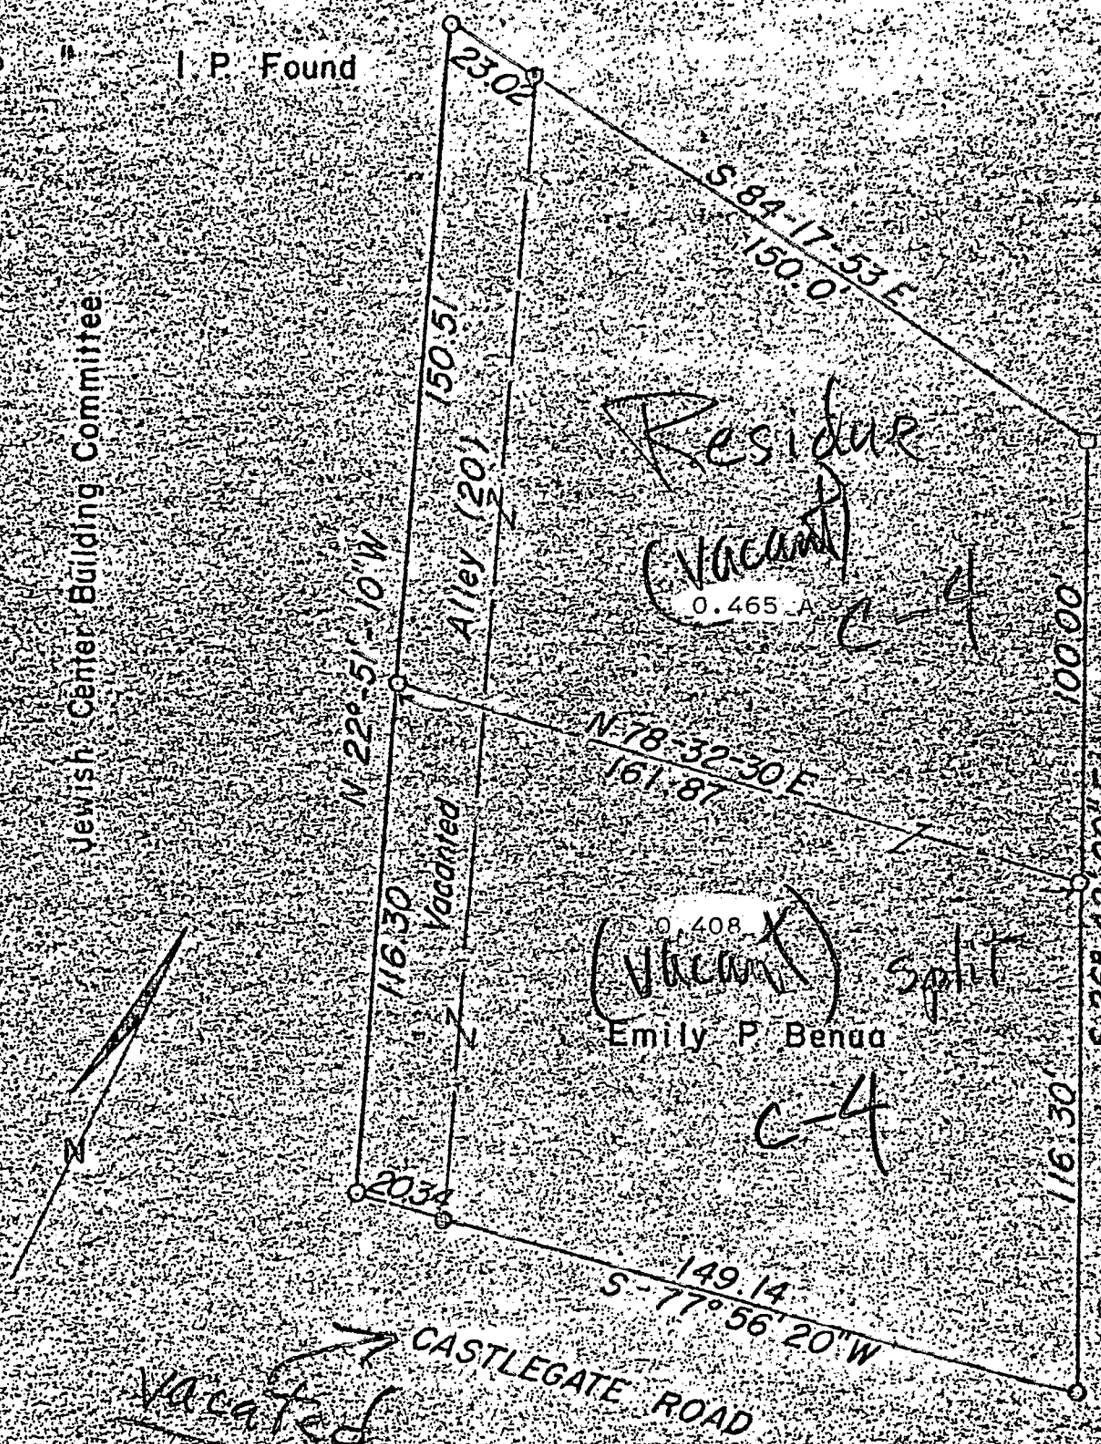

We hereby certify that the foregoing drawing was prepared from an actual survey of the premises and correctly shows the location of the boundries.

DRAWN BY BA

REGISTERED SURVEYOR NO. 7222

S. D. POMEROY
ENGINEERING & SURVEYING
1345 Shanley Drive Columbus 24, Ohio