184357100

Myers Surveying Company, Inc.

2740 East Main Street, Columbus 43209 (Bexley), Ohio
614-235-8677 FAX: 614-235-4559

A Boundary Survey prepared for and certified to:
Neil and Janet Lantz

Legal Description: Being 0.015 Acres, Part of Lot 22 Bexley Drive Subdivision #2 Plat Book 14, Page 1 Franklin County Recorders Office

Applicant: LANTZ

Posted Address: 727 Sheridan Avenue, Bexley, Ohio

Apparent Encroachments: 1) Concrete Over Property Line. 2) Eaves and Gutters Over Property Line.

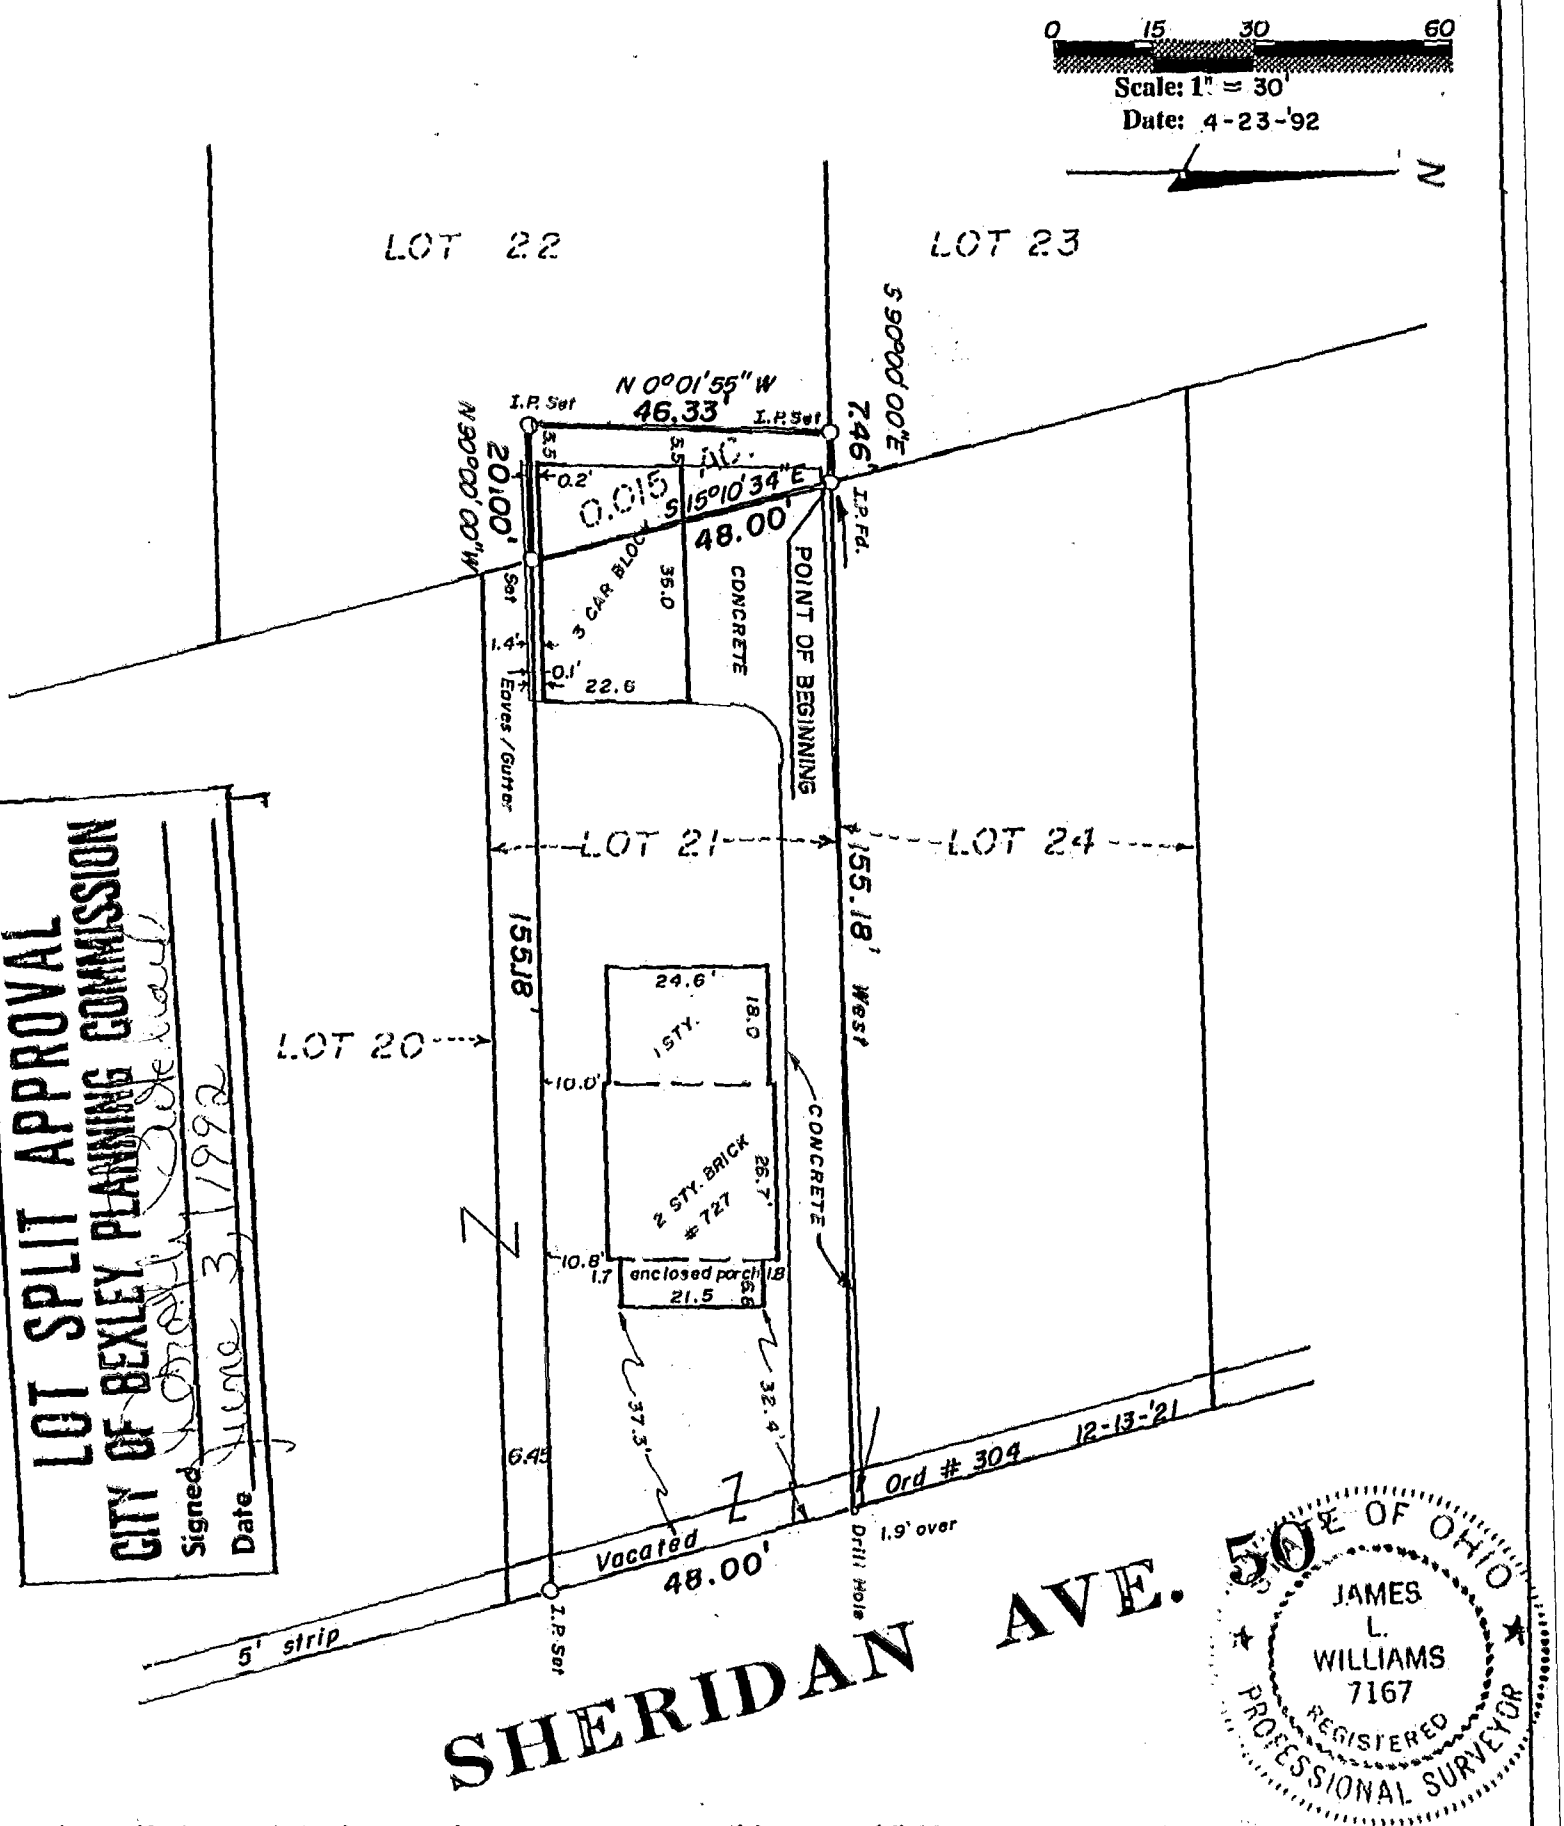

STATE OF OHIO
JAMES L. WILLIAMS 7167
REGISTERED PROFESSIONAL SURVEYOR

We hereby certify that the foregoing Boundary Survey was prepared from actual field measurements in accordance with Chapter 4733-37 Ohio Administrative Code. Iron pins set are 30"x1" O.D. with an orange plastic plug inscribed "P.S. 6579", unless otherwise noted. Basis of bearing is assumed.

Myers Surveying Co., Inc.
By James L. Williams
Professional Surveyor

Myers Order No. - 32-92-04-13	Rec.	Field	DWG	Ltr.	Ck.