

# MYERS SURVEYING Co.

2740 East Main Street, Columbus 43209 (Bexley), Ohio

LOT 23, PART LOT 24, BLK. 3, ROSARY SUB. COLUMBUS, OHIO


F o r

MR. ANTHONY J. MARTIN

P.B. 23 Page 10  
Scale 1"=20'

Franklin Co. Rec. Office  
10-27-86

M-73

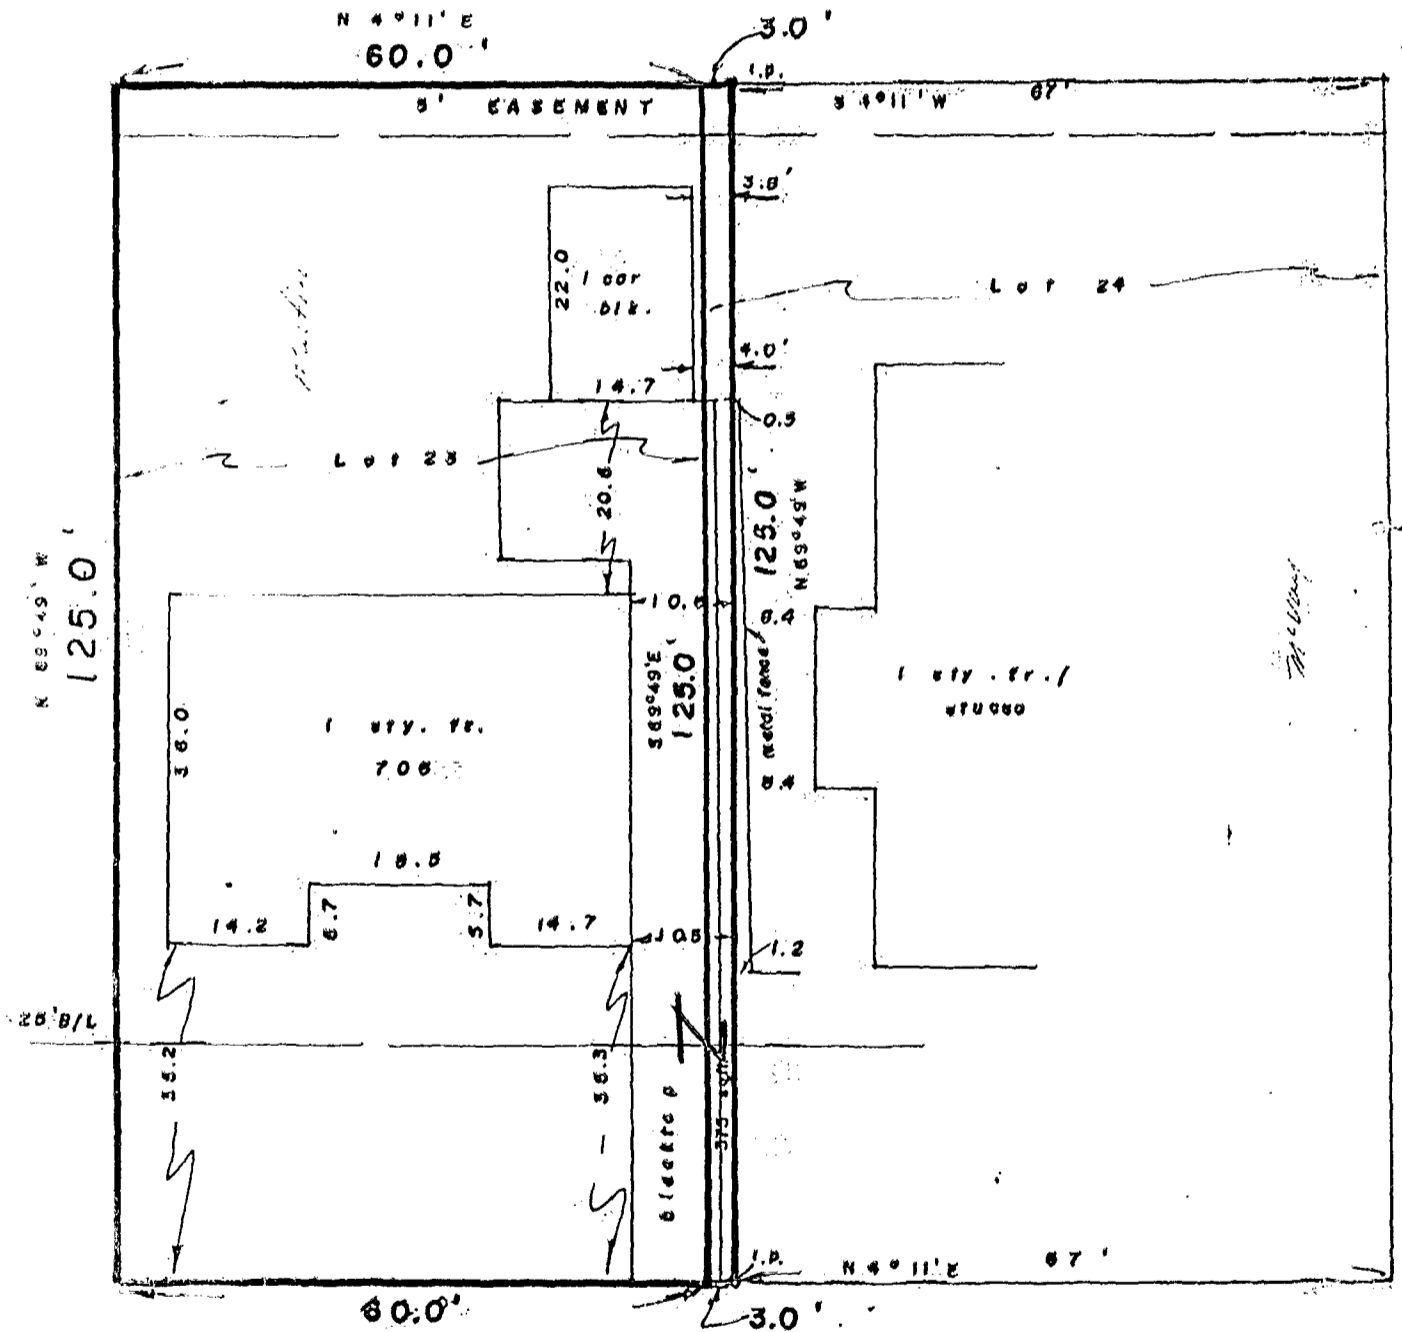

JOYFUL ST. 50'



We hereby certify that the foregoing plat was prepared from an actual survey of the premises. No side line of principal building is less than dimension shown. Iron pins not set unless indicated thus -0-

MYERS SURVEYING CO.

BY Albert J. Myers  
Registered Surveyor