EVANS MECHWART HAMBLETON & TILTON, INC.
CONSULTING ENGINEERS — SURVEYORS
GAHANNA, OHIO

0.720 Ac

SURVEY OF 0.720 ACRE TRACT

Located in Virginia Military Survey Nº 1396

City of Columbus, Franklin County, Ohio

SCALE 1" = 60'

December 17, 1971

DEED BOOK 3089, PAGE 34

PLAT BOOK ___, PAGE ___

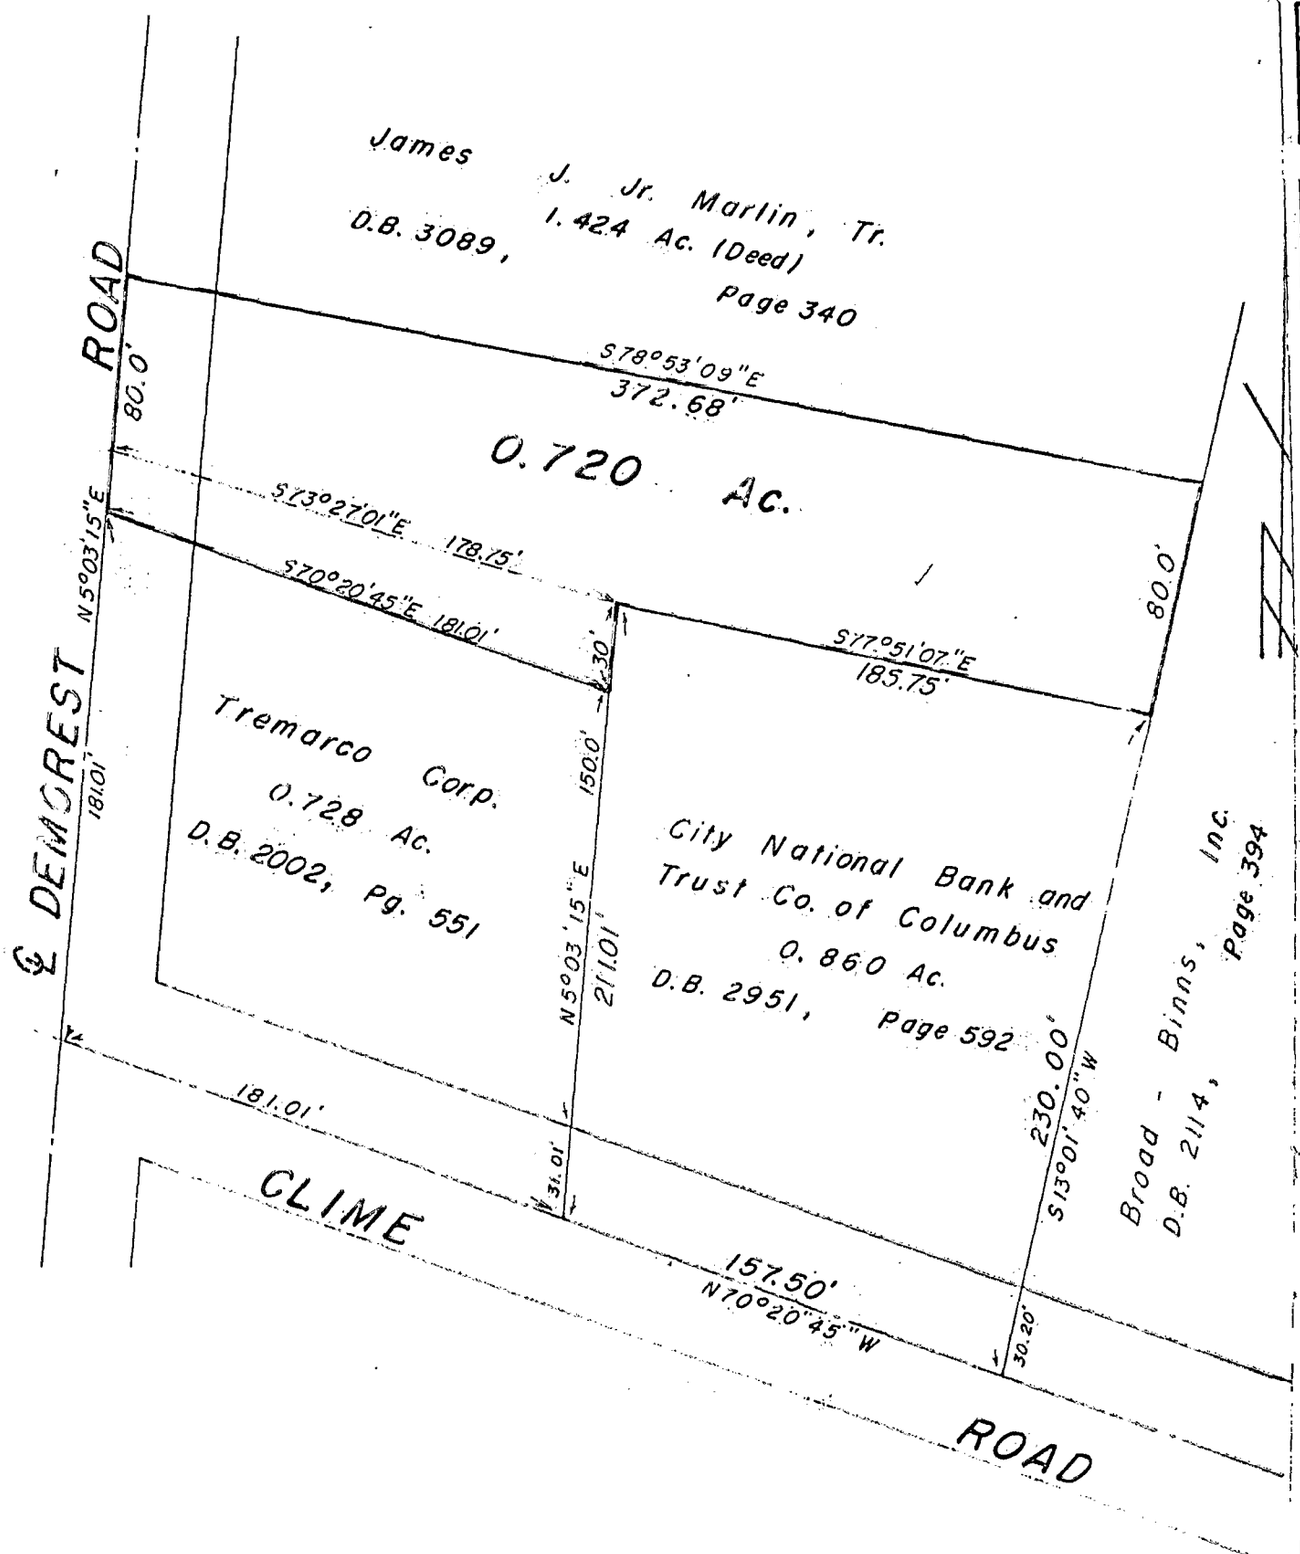

We hereby certify that the foregoing plat was prepared from an actual survey of the premises and shows the location of the boundaries.

EVANS MECHWART HAMBLETON & TILTON, INC.

BY E. E. Maddy

Registered Surveyor No. 4963