THE THOMAS ENGINEERING & SURVEYING COMPANY

3803 SULLIVANT AVENUE COLUMBUS, OHIO 43228

ORDER NO. 165-69

0-20-F (69-671)

FRANKLIN 0-20-13

PLAT OF SURVEY

OF A 1.000 ACRE TRACT LOCATED IN THE STATE OF OHIO, COUNTY OF FRANKLIN, TOWNSHIP OF FRANKLIN V.M.S. SURVEY NO. 971

FOR: JOE WATKINS & CENTRAL REALTY

SCALE 1" 40'

JUNE 1969

Highway Easement (cross-hatched) contains 0.175 acre of which 0.105 acre is in the present right-of-way

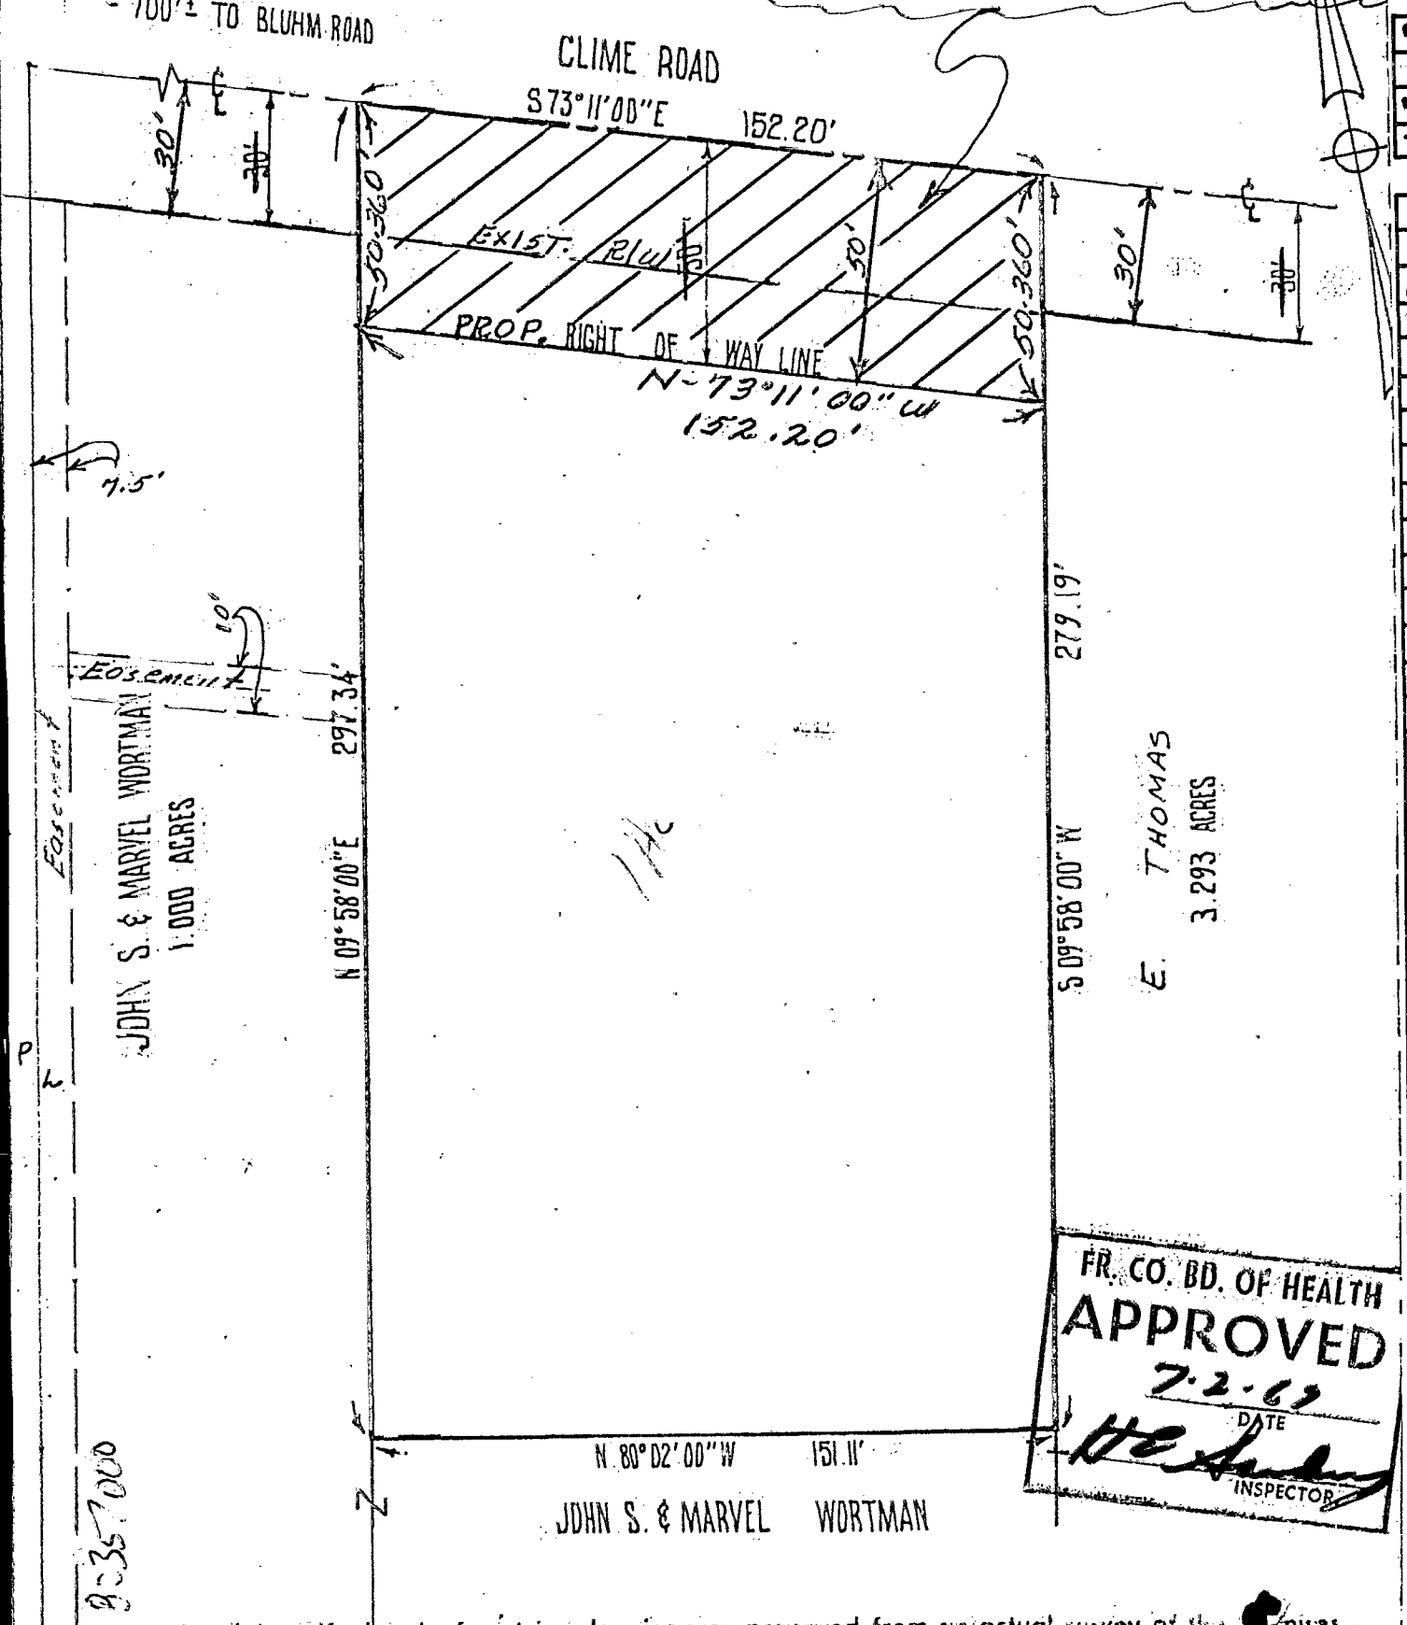

We hereby certify that the foregoing drawing was prepared from an actual survey of the premises and correctly shows the location of the boundaries.

NOTE!

THE ABOVE HAS BEEN DRAWN FROM A FIELD SURVEY MADE IN 1949

THE THOMAS ENGINEERING & SURVEYING CO.

Registered Surveyor

4/4

C-1419