MYERS SURVEYING CO.
2740 East Main Street, Columbus 9 (Bexley), Ohio

M 188

LOT 6, COMMONWEALTH PLAZA, AND PART OF A TRACT CONVEYED TO KING AVE. INC. (D.B. 3069, P. 2), IN COLUMBUS, OHIO 18110 7050
18135 7050

KING AVE., INC

P.B. 24 Page 16 BOARD OF EDUCATION (10-3-51) Franklin Co. Rec. Office
Scale 1" = 15'
4-13-'73

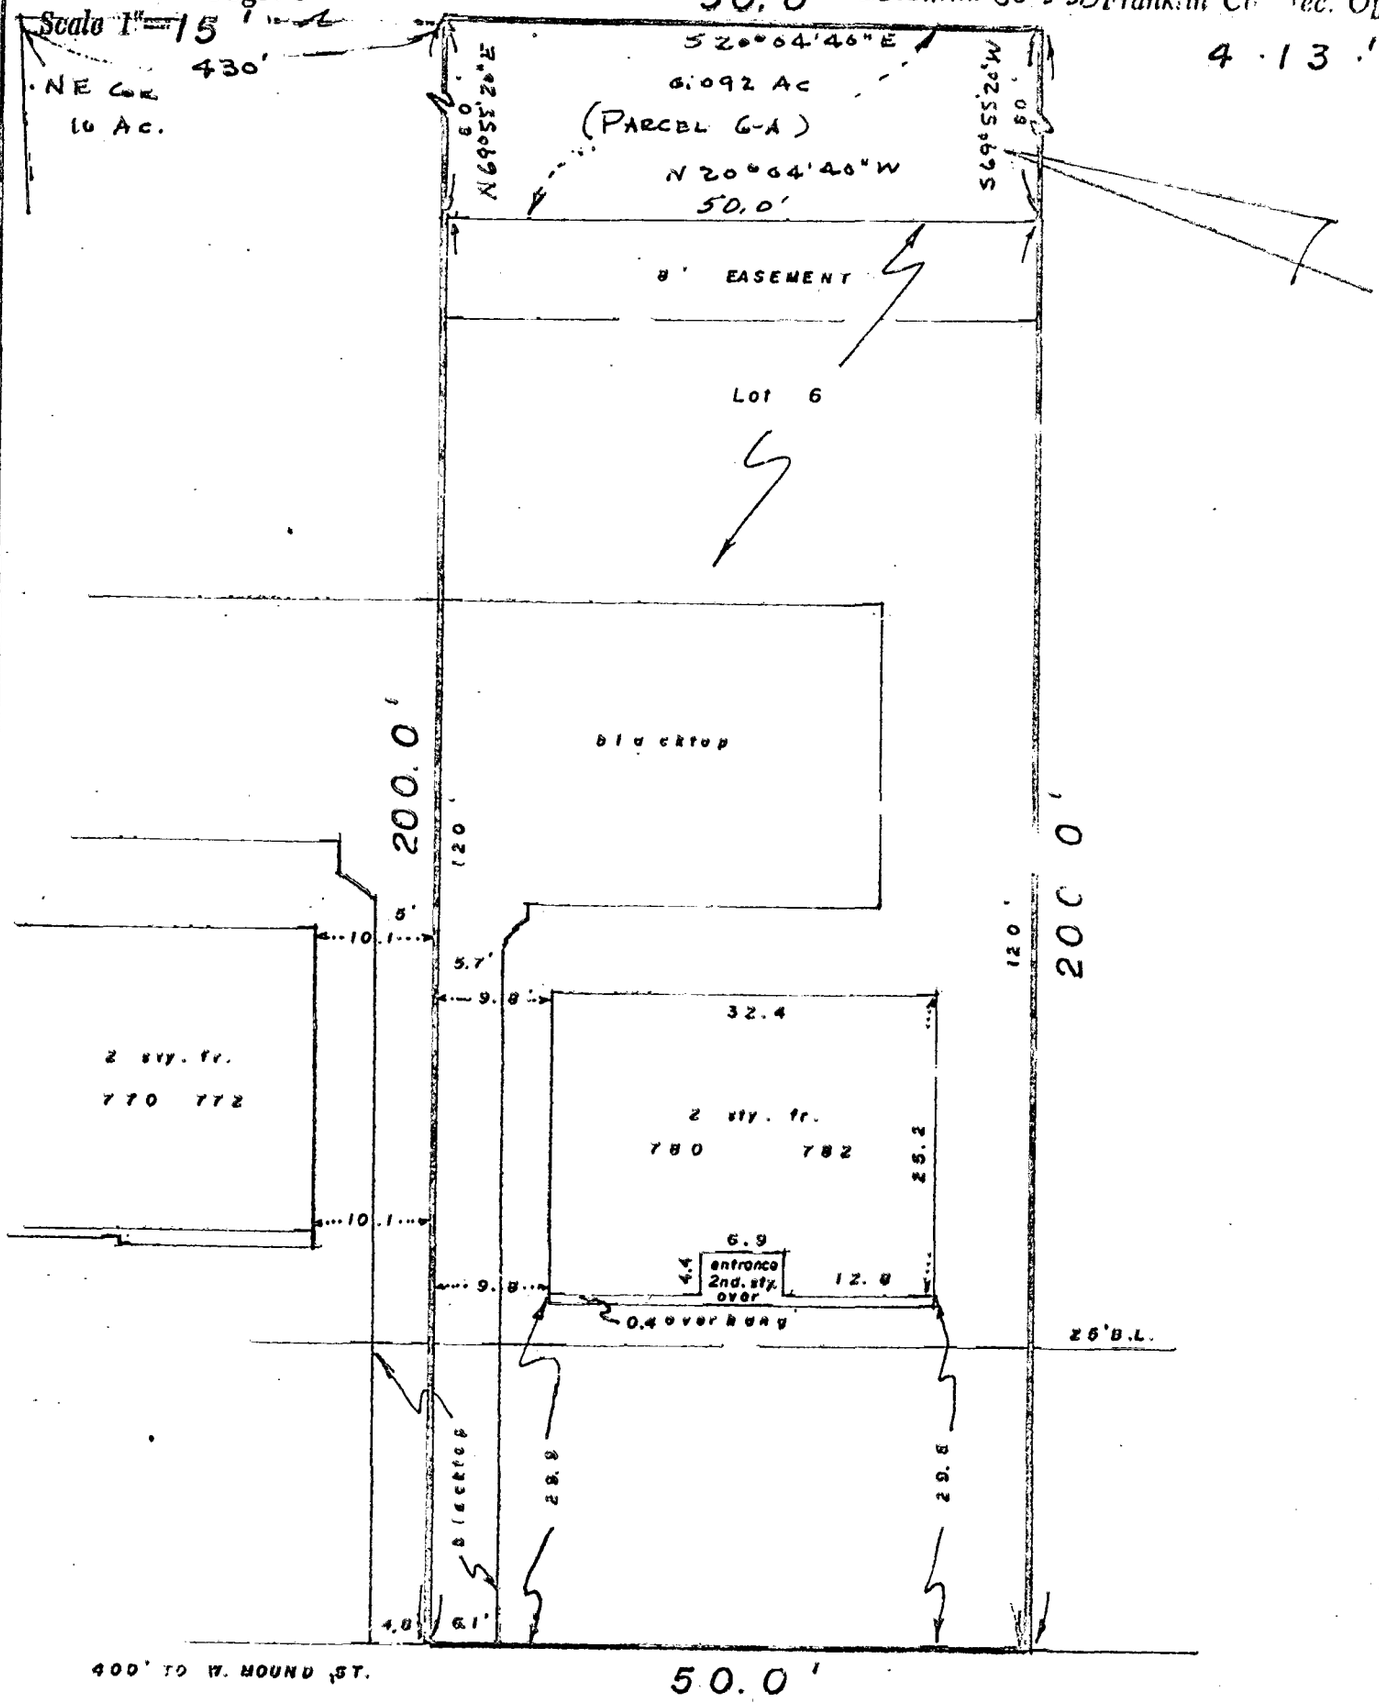

BUTLER AVE. 50'

We hereby certify that the foregoing plat was prepared from an actual survey of the premises. No side line of principal building is less than dimension shown. Iron pins not set unless indicated thus —0—. For Mortgage Loan & Title Insurance purposes only.

MYERS SURVEYING CO
BY Everett O. Myers
Registered Surveyor