

490 City Park
Columbus, Ohio
CA. 1-9694

JOHN CIRCLE
ENGINEER - SURVEYOR

187 Sinsbury Drive
Worthington, Ohio
TU. 5-8248


Civil Engineer
Professional Surveyor

Reg. No. 19131
Reg. No. 4340

OWNER: Earl W. Swingle Subdivision: Acres Deed: 1388 Page: 168
ADDRESS: 2478 Briggs Rd. Township: Franklin; U.M.W. 971
County: Franklin Lot No. _____ Plat _____ Page _____

FRANKLIN

0-20-A

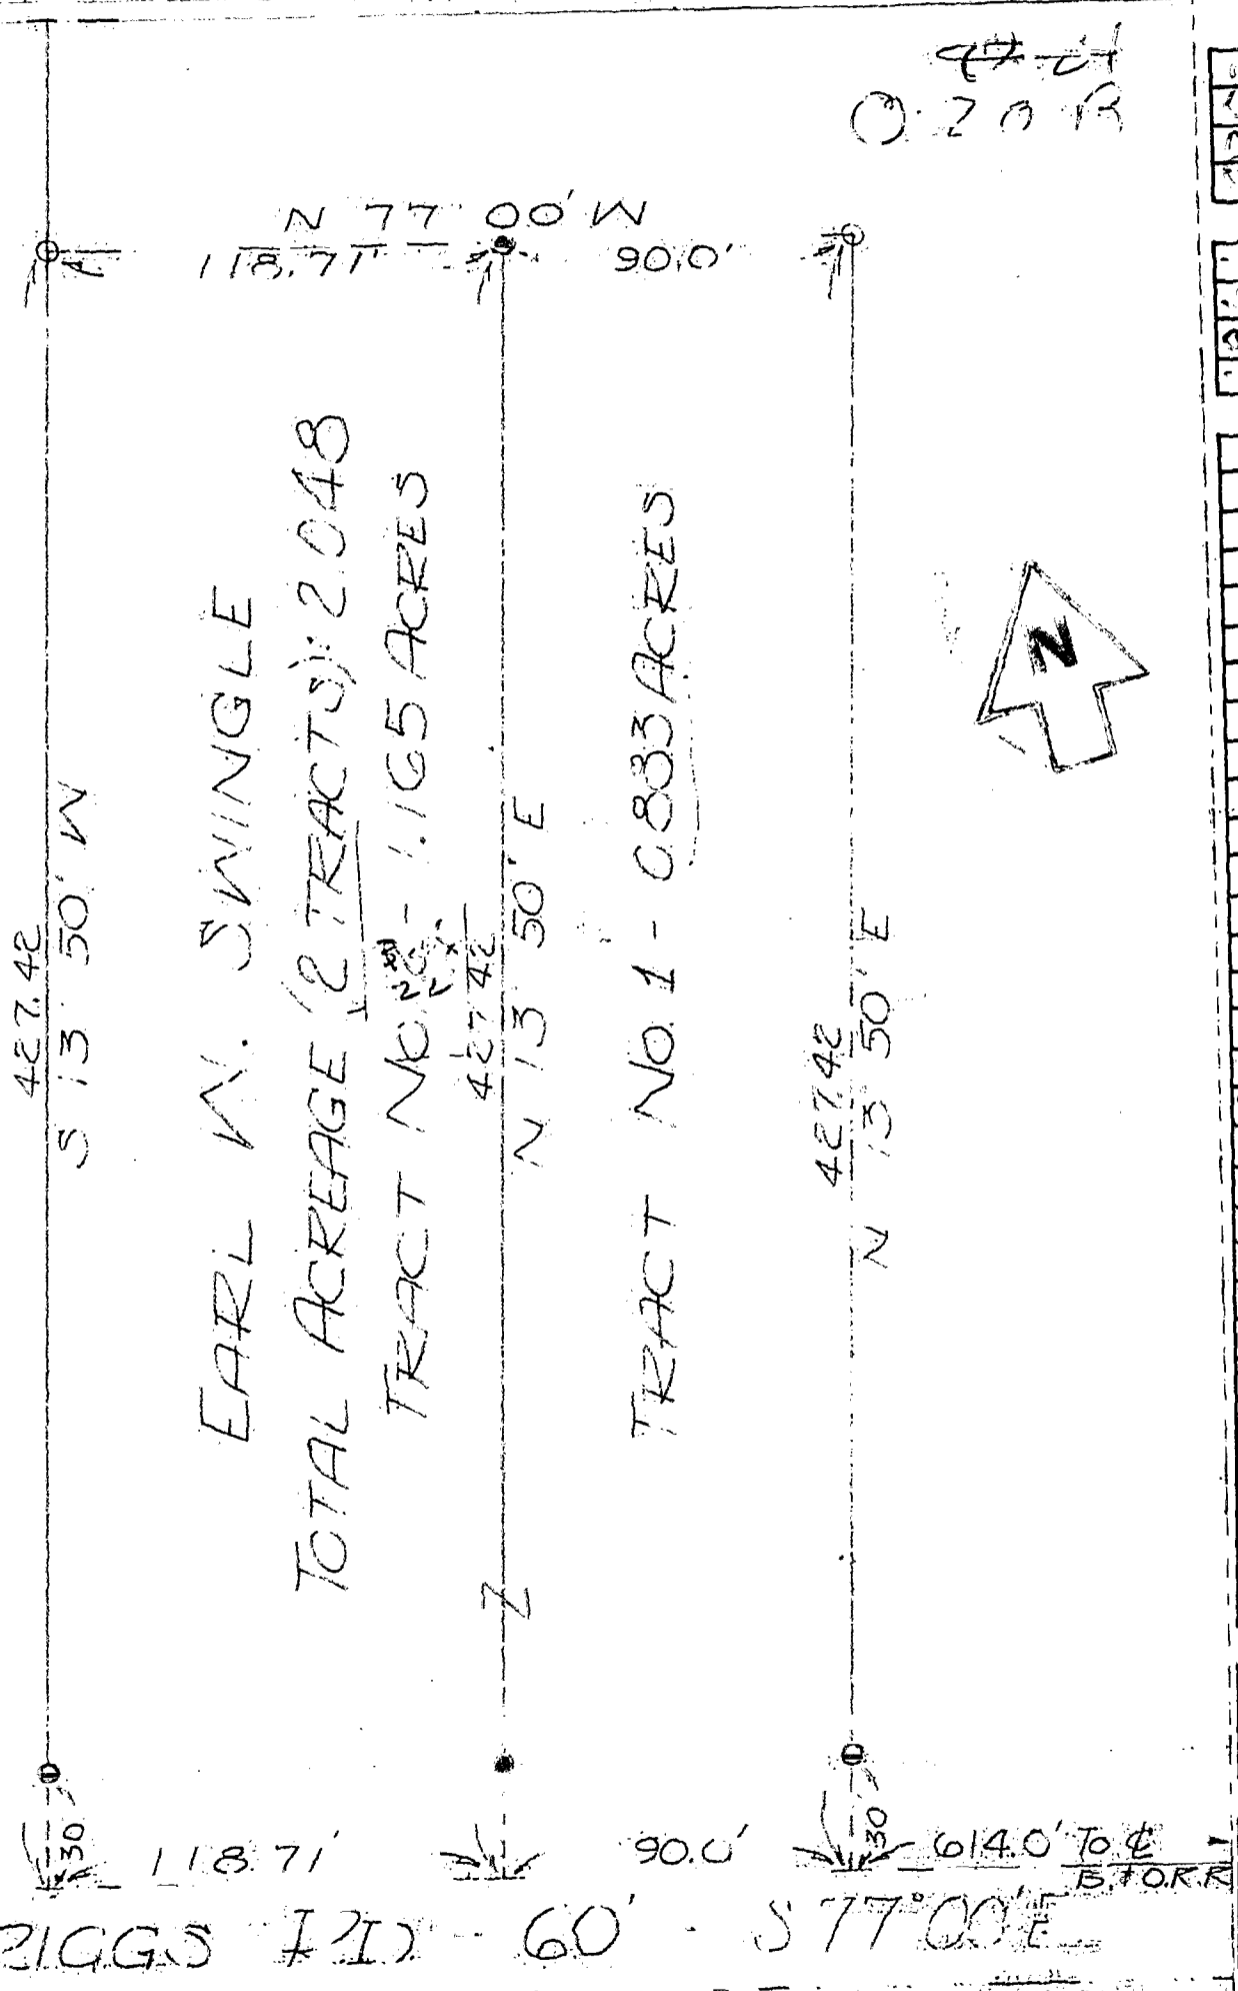

8107025

03
0203
0961
068
013
020
0450

To all parties interested in title to premises: I hereby certify that the foregoing drawing was prepared from an actual survey of the premises and shows the location of the boundaries

Drawn By: C.H. Scale: 1" = 50' LEGEND: Exist. Iron Pin New Iron Pin
Checked By: [Signature] Dwg. No. 1679 Date July 1961 John Circle
JOHN CIRCLE, ENGINEER, SURVEYOR