


18010.64 1/3

177-148-3

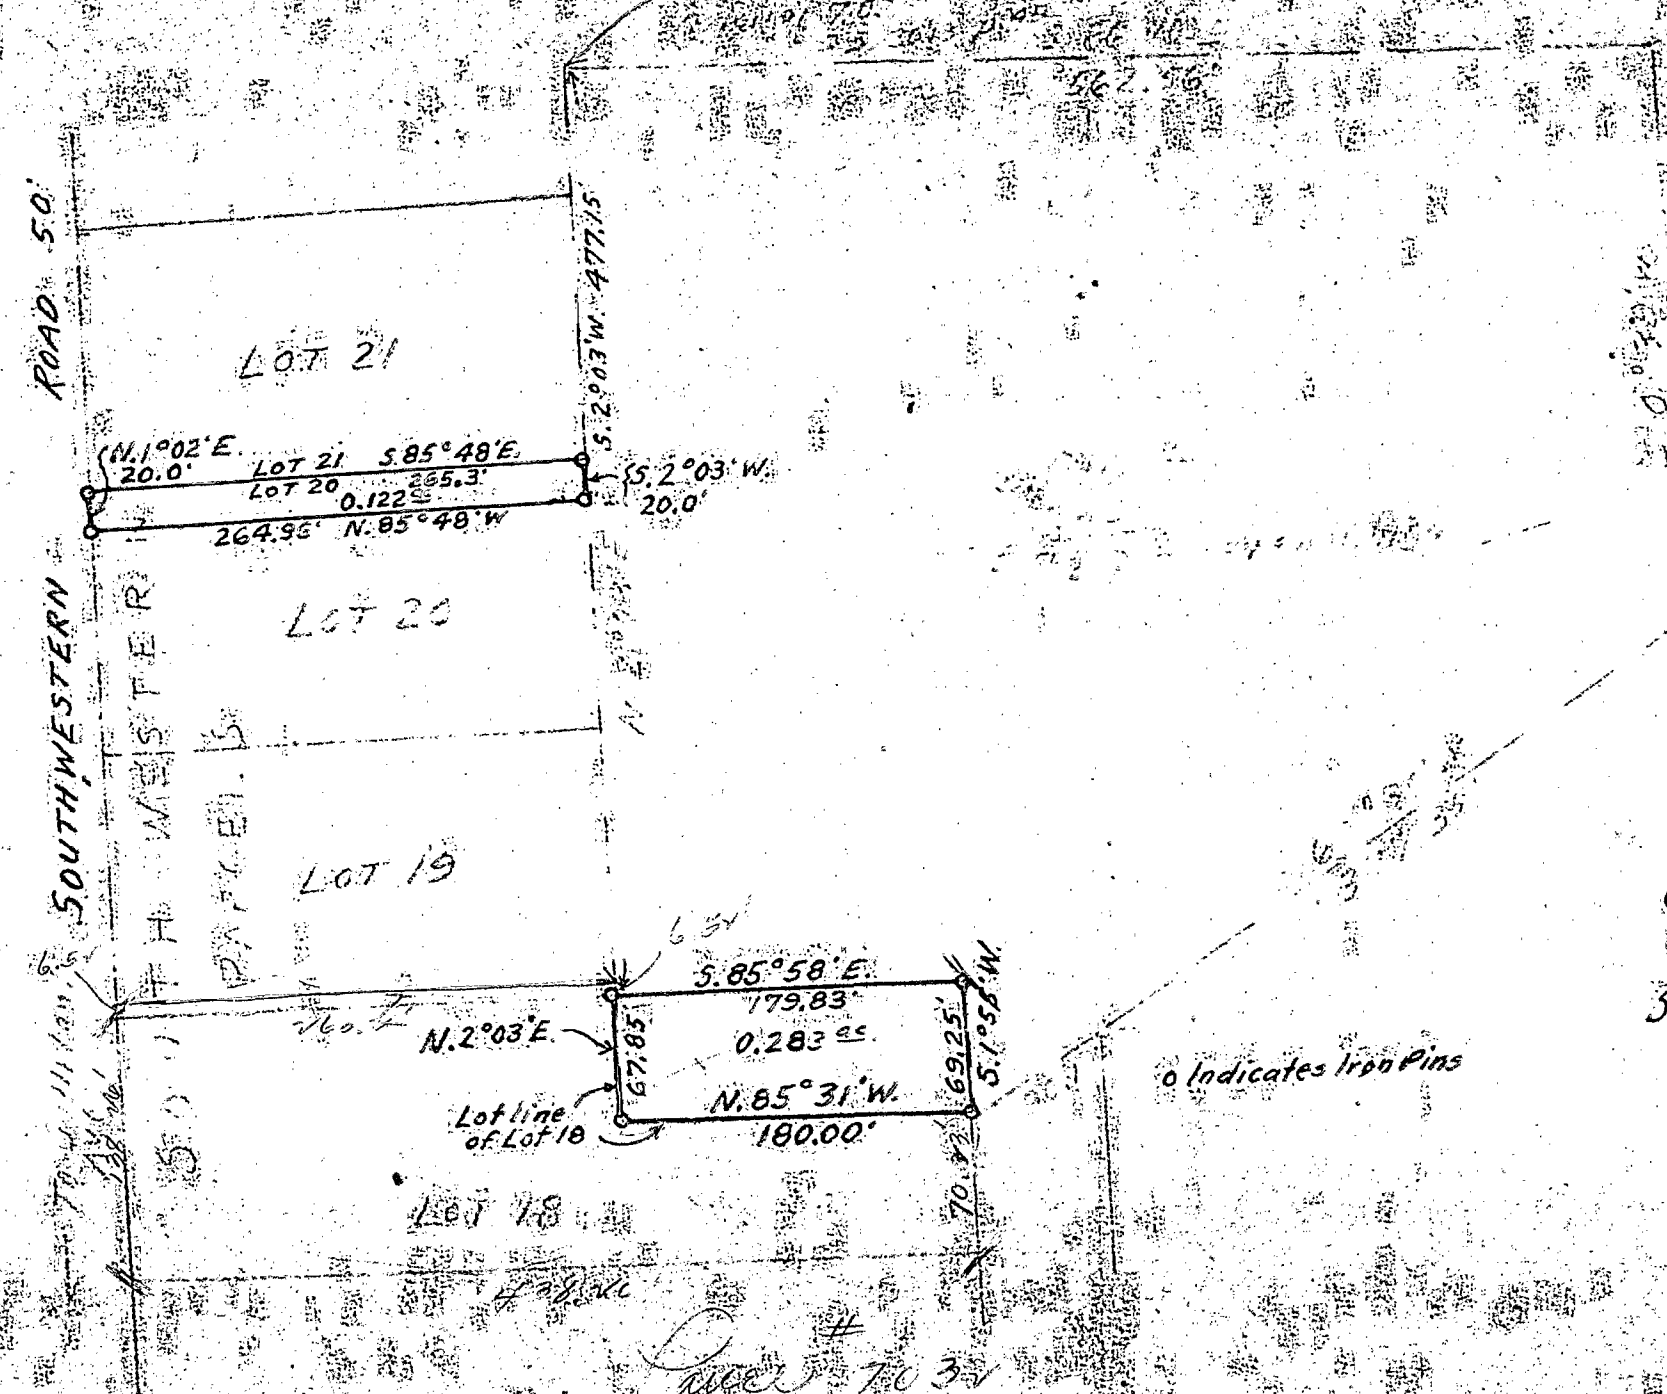

SURVEY of 0.283<sup>ac</sup> & 0.122<sup>ac</sup>  
TRACTS

0.122<sup>ac</sup> off North Side Lot 20  
SOUTHWESTERN PARCELS SUBDN.  
recorded in Auditors Plat BK II, p. 91

0.283<sup>ac</sup> out of Original 7.02<sup>ac</sup> Tract  
recorded in Deed Vol. 2013, p. 412

Survey No. 1389 VIRGINIA MIL. LANDS  
FRANKLIN TWP. FRANKLIN CO., O.  
SCALE: 1" = 100' JUNE, 1957

Surveyed for:  
MR. O. C. DOTY & MR. GEO. PAINTER

F. K. Harvey  
Registered Surveyor No. 2570

Over to 3rd  
Harold J. Insley