


JACKSON TWP.
O-29-A


79856975
79856950

1/4 sec. 500 ft
3,800
28 3666 1/2 637

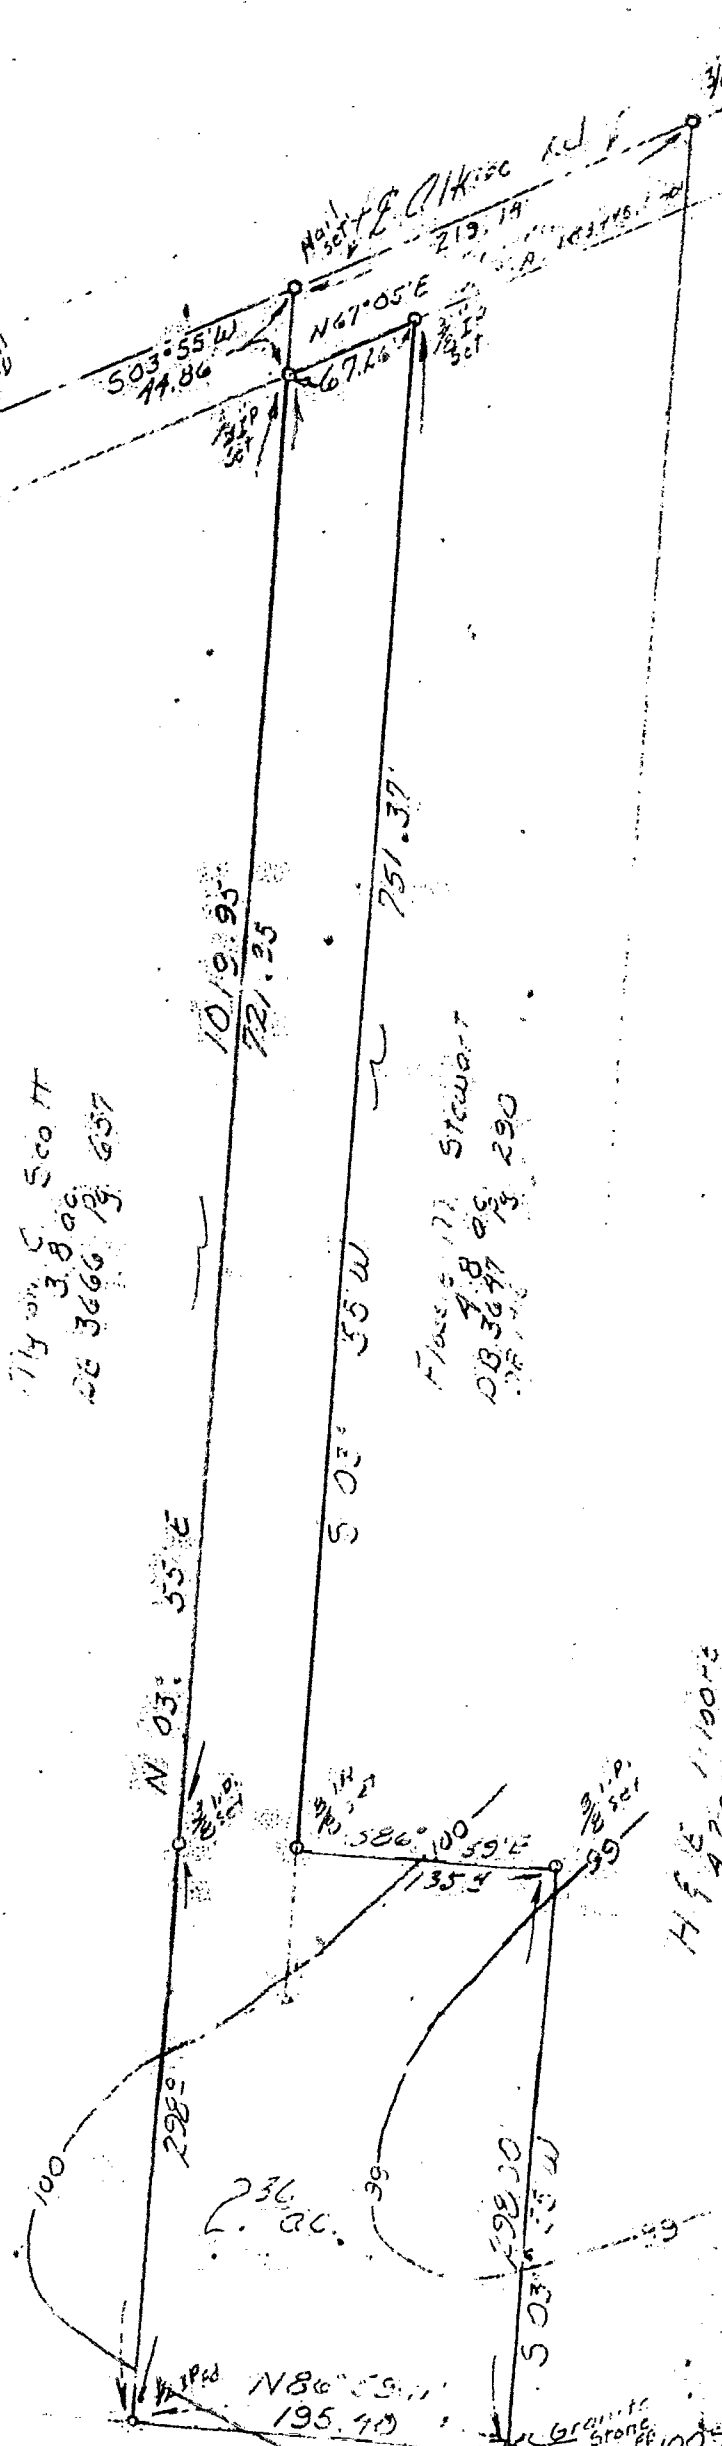

Plat 5 177 Stewart
DB 3647 1/2 290

H F E 1,100 ft
DB 2166 1/2 157

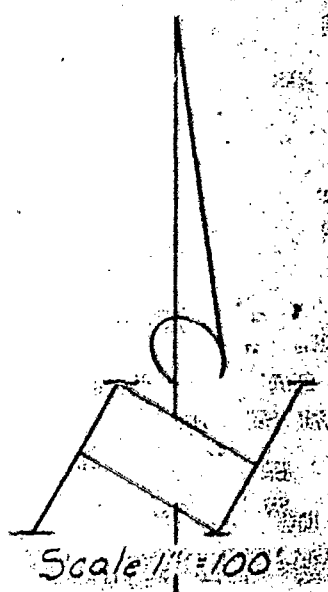

Survey of 236 acres
in V175 #1389, Jackson Twp.
Franklin Co., Ohio.

John Rice



HEREBY CERTIFY THE PLAT SHOWN HEREBY
WAS ACCURATELY SURVEYED BY US.
DATE: October 20 1953
Louis F. Heinas
Revised Nov. 1953 LHH

Louis F. Heinas


Phyllis K. Shawe
OR 7/10/55

Granite Stone
1/100