


80356950

JACKSON TWP.
0-29-B

Exhibit B

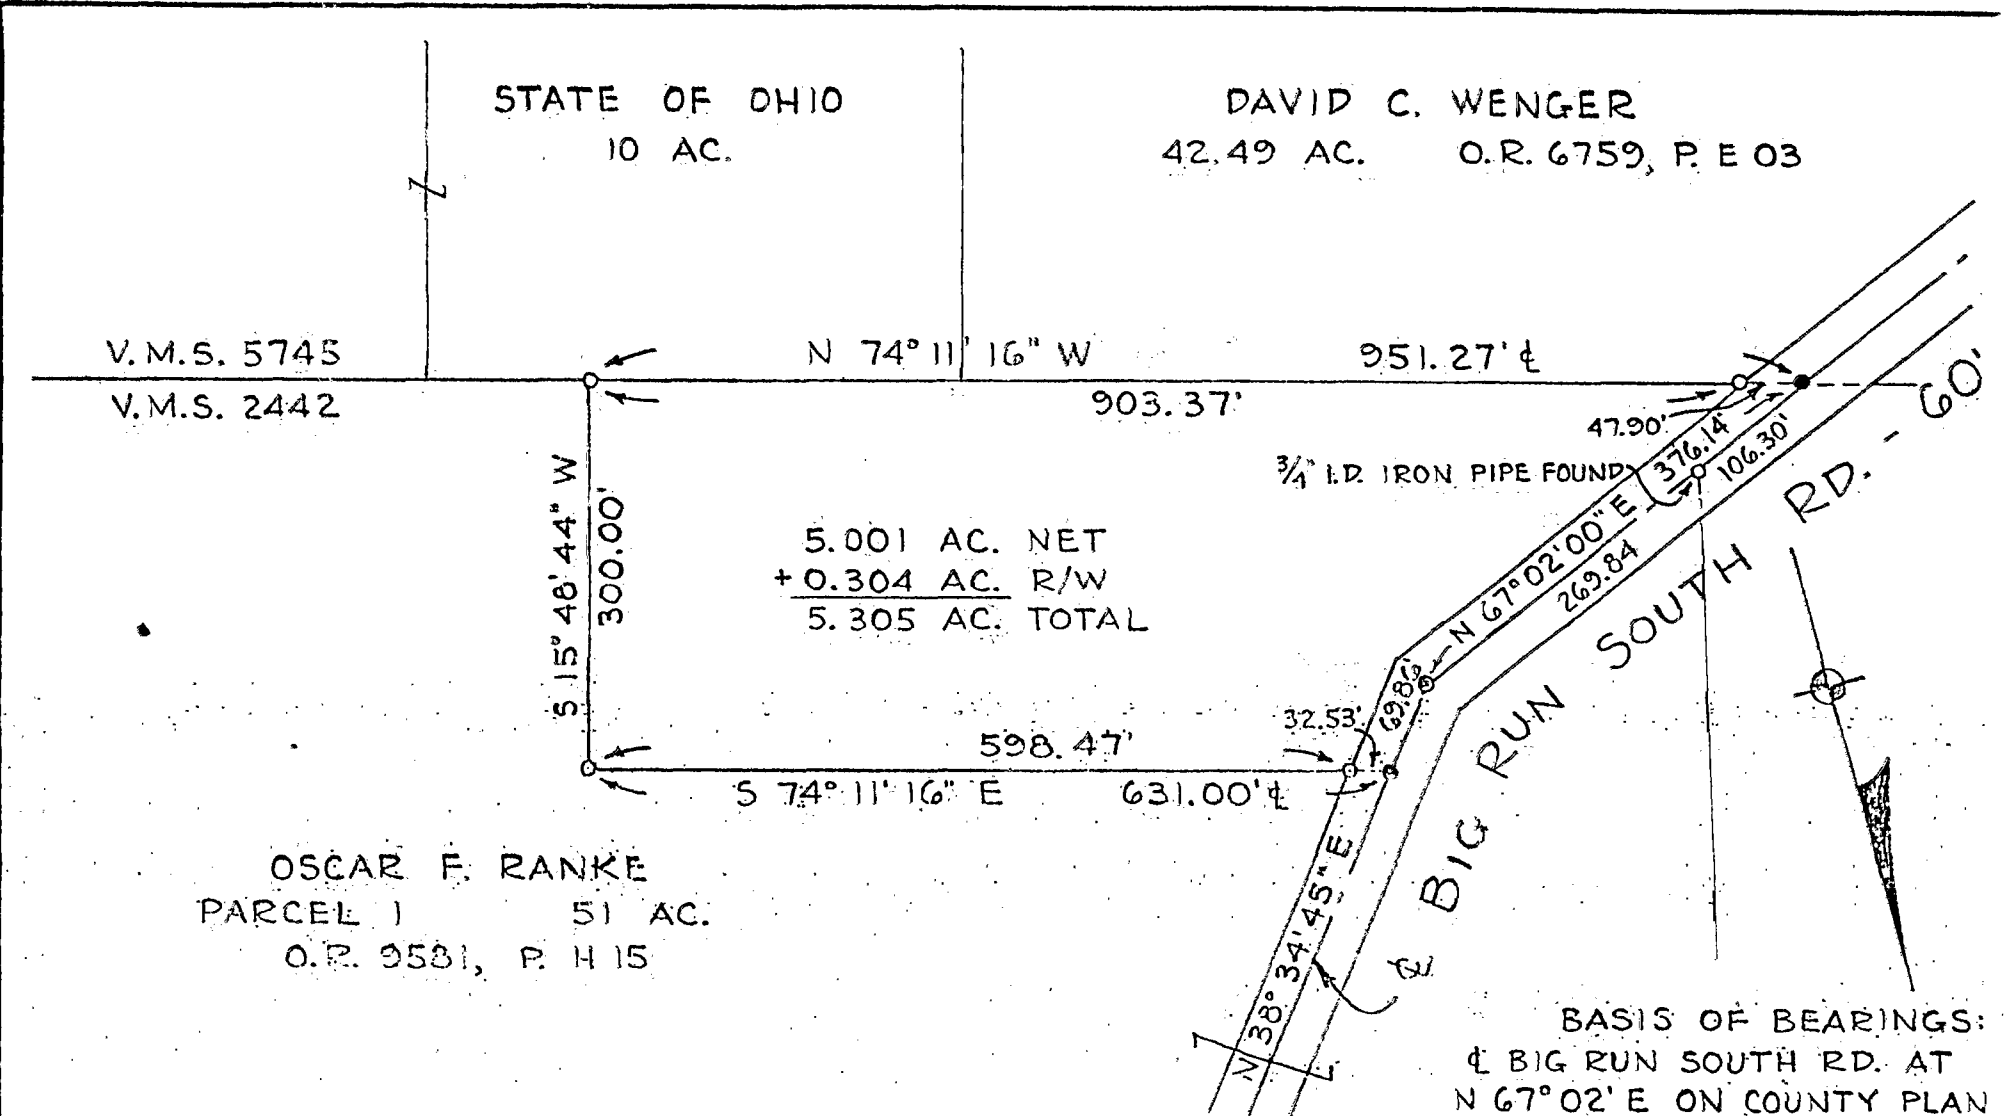

STATE OF OHIO
10 AC.

DAVID C. WENGER
42.49 AC. O.R. 6759, P. E 03

V.M.S. 5745
V.M.S. 2442

N 74° 11' 16" W

951.27'

903.37'

S 15° 46' 44" W
300.00'

5.001 AC. NET
+ 0.304 AC. R/W
5.305 AC. TOTAL

S 74° 11' 16" E
598.47'

631.00'

3/4" I.D. IRON PIPE FOUND

N 67° 02' 00" E
269.84'

N 38° 34' 45" E

BIG RUN SOUTH RD. - 60'

OSCAR F. RANKE
PARCEL 1 51 AC.
O.R. 9581, P. H 15

BASIS OF BEARINGS:
⊕ BIG RUN SOUTH RD. AT
N 67° 02' E ON COUNTY PLAN
FOR ROAD NO. 258. (SHEET
14 OF 33)

SURVEY OF 5.305 AC. IN V.M.S. 2442,
JACKSON TWP., FRANKLIN COUNTY, OHIO, FOR MR. OSCAR F. RANKE

C.F. BIRD & R.J. FULL, INC.
2875 W. DUBLIN-GRANVILLE RD.
WORTHINGTON, OHIO

SCALE: 1" = 150' JULY 22, 1988

⊕ - 3/4" I.D. IRON PIPE SET
● - RAILROAD SPIKE SET

DJB

88-223