

JERRY A. MALOTT SURVEYING Co.


6810 East Main Street ~ Suite 101, Columbus, Ohio 43068 (614) 577-0957

FOR: TIMOTHY R. FARKAS


BOUNDARY SURVEY

ORDER #9391

89106950

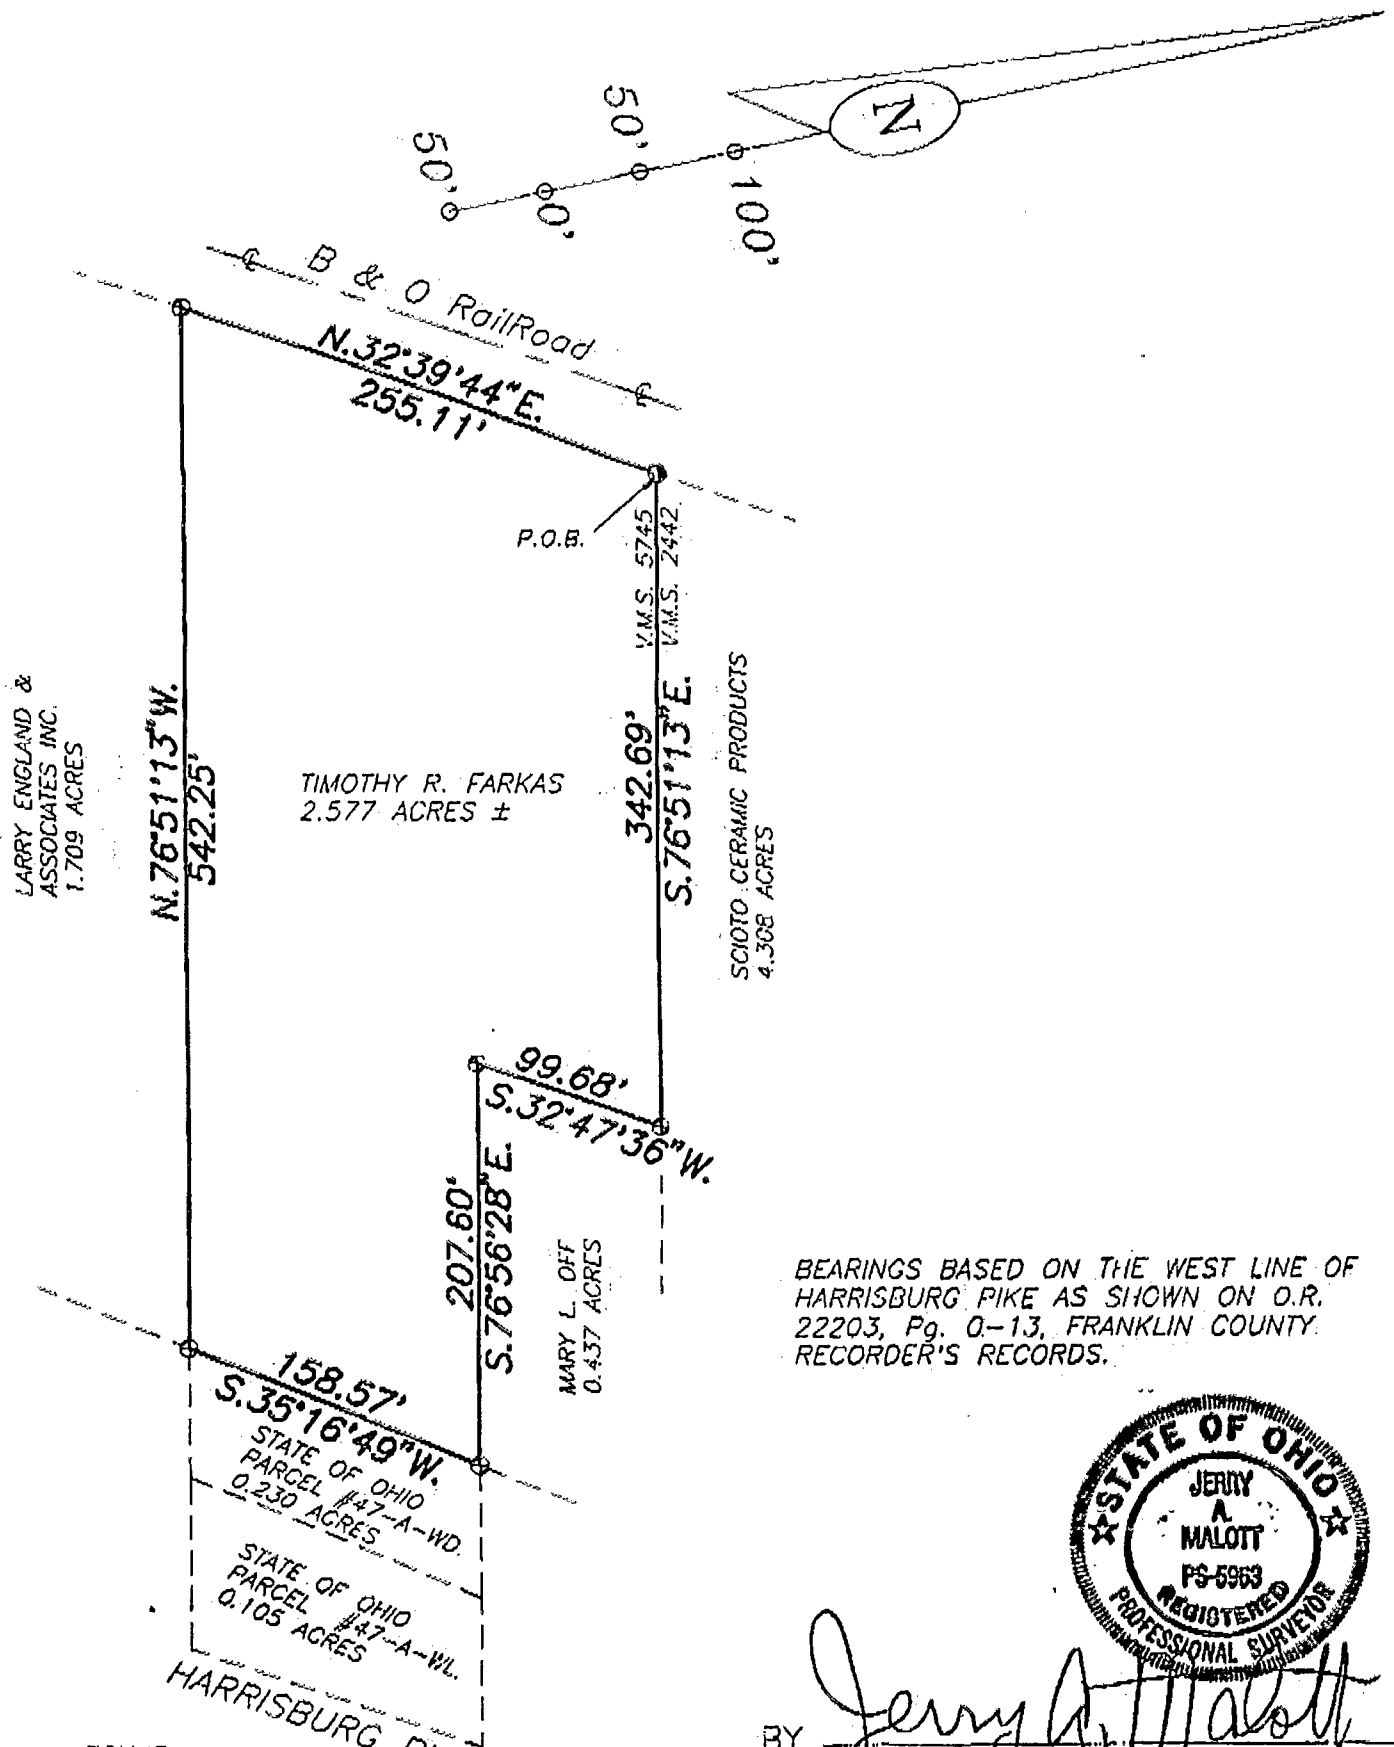

BEARINGS BASED ON THE WEST LINE OF HARRISBURG PIKE AS SHOWN ON O.R. 22203, Pg. 0-13, FRANKLIN COUNTY RECORDER'S RECORDS.

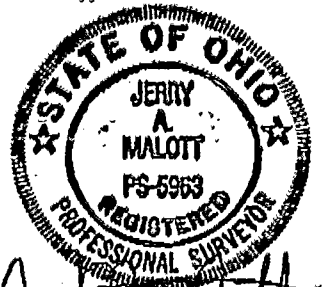

BY Jerry A. Malott
 Professional Surveyor
 JERRY A. MALOTT

JACKSON TWP.

- LEGEND
- IRON PIPE SET
 - ⊙ IRON PIPE FOUND

SCALE 1" = 100' DATE 11-1-93

LOCATION STATE OF OHIO, COUNTY OF FRANKLIN AND THE TOWNSHIP OF JACKSON, PRIOR DEED REFERENCE O.R. 16990 Pg. D03.

V.M.S. 5745

0-29-C