


0-29-C
JACKSON TWP.

IRON PIN FOUND
212.71' DEED SURVEY
212.62' SURVEY
S 35° 32' 04" W

OHIO WIRE SPRING CO.
DEED BOOK 2914 PAGE 658
2.604 ACRES

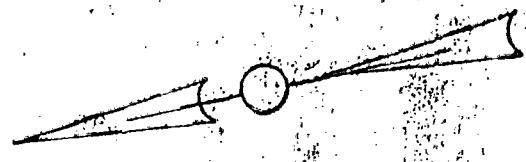

SCALE 1" = 60'

533.82' DEED
533.97' SURVEY
S 76° 51' 53" E

528.07' DEED
527.89' SURVEY
N 81° 15' 03" W

OHIO DEPT. OF HWYS. PROJECT FRA-270-609S
& SERVICE ROAD 'A'

10.00' DEED SURVEY
10.00' DEED SURVEY
N 57° 20' 03" W

132.57' DEED SURVEY
132.64' DEED SURVEY
N 32° 39' 24" E

115.15' DEED SURVEY
115.20' DEED SURVEY
N 32° 39' 30" E

IRON PINS FOUND
& B. & O. R.R.

SURVEYED BY:
ROBERT B. LUCAS
REG. SURVEYOR NO. 3979

Robert B. Lucas

SURVEY FOR OHIO WIRE SPRING CO.
2.604 ACRES - S. PART, LOT NO. 1
(CASE OF LOUISE RUFFING ET AL. VS.
ANNA MARIA SCHMIDT- COMPL. REC. 139,
PG. 577, CT. OF COMMON PLEAS. FR. CO., OHIO)
JACKSON TWP., FRANKLIN CO., OHIO
VA. MIL. SURVEY NO. 5745

DODSON-LINDBLOM ASSOCIATES, INC.
CONSULTING ENGINEERS
COLUMBUS, OHIO

NOV, 1972

80606950
25603985