


Job No 70-319
 81106975
 0-20-2
 0-20-2
 0310 120 012 062 S BIG RUN ROAD 1000 0209 03

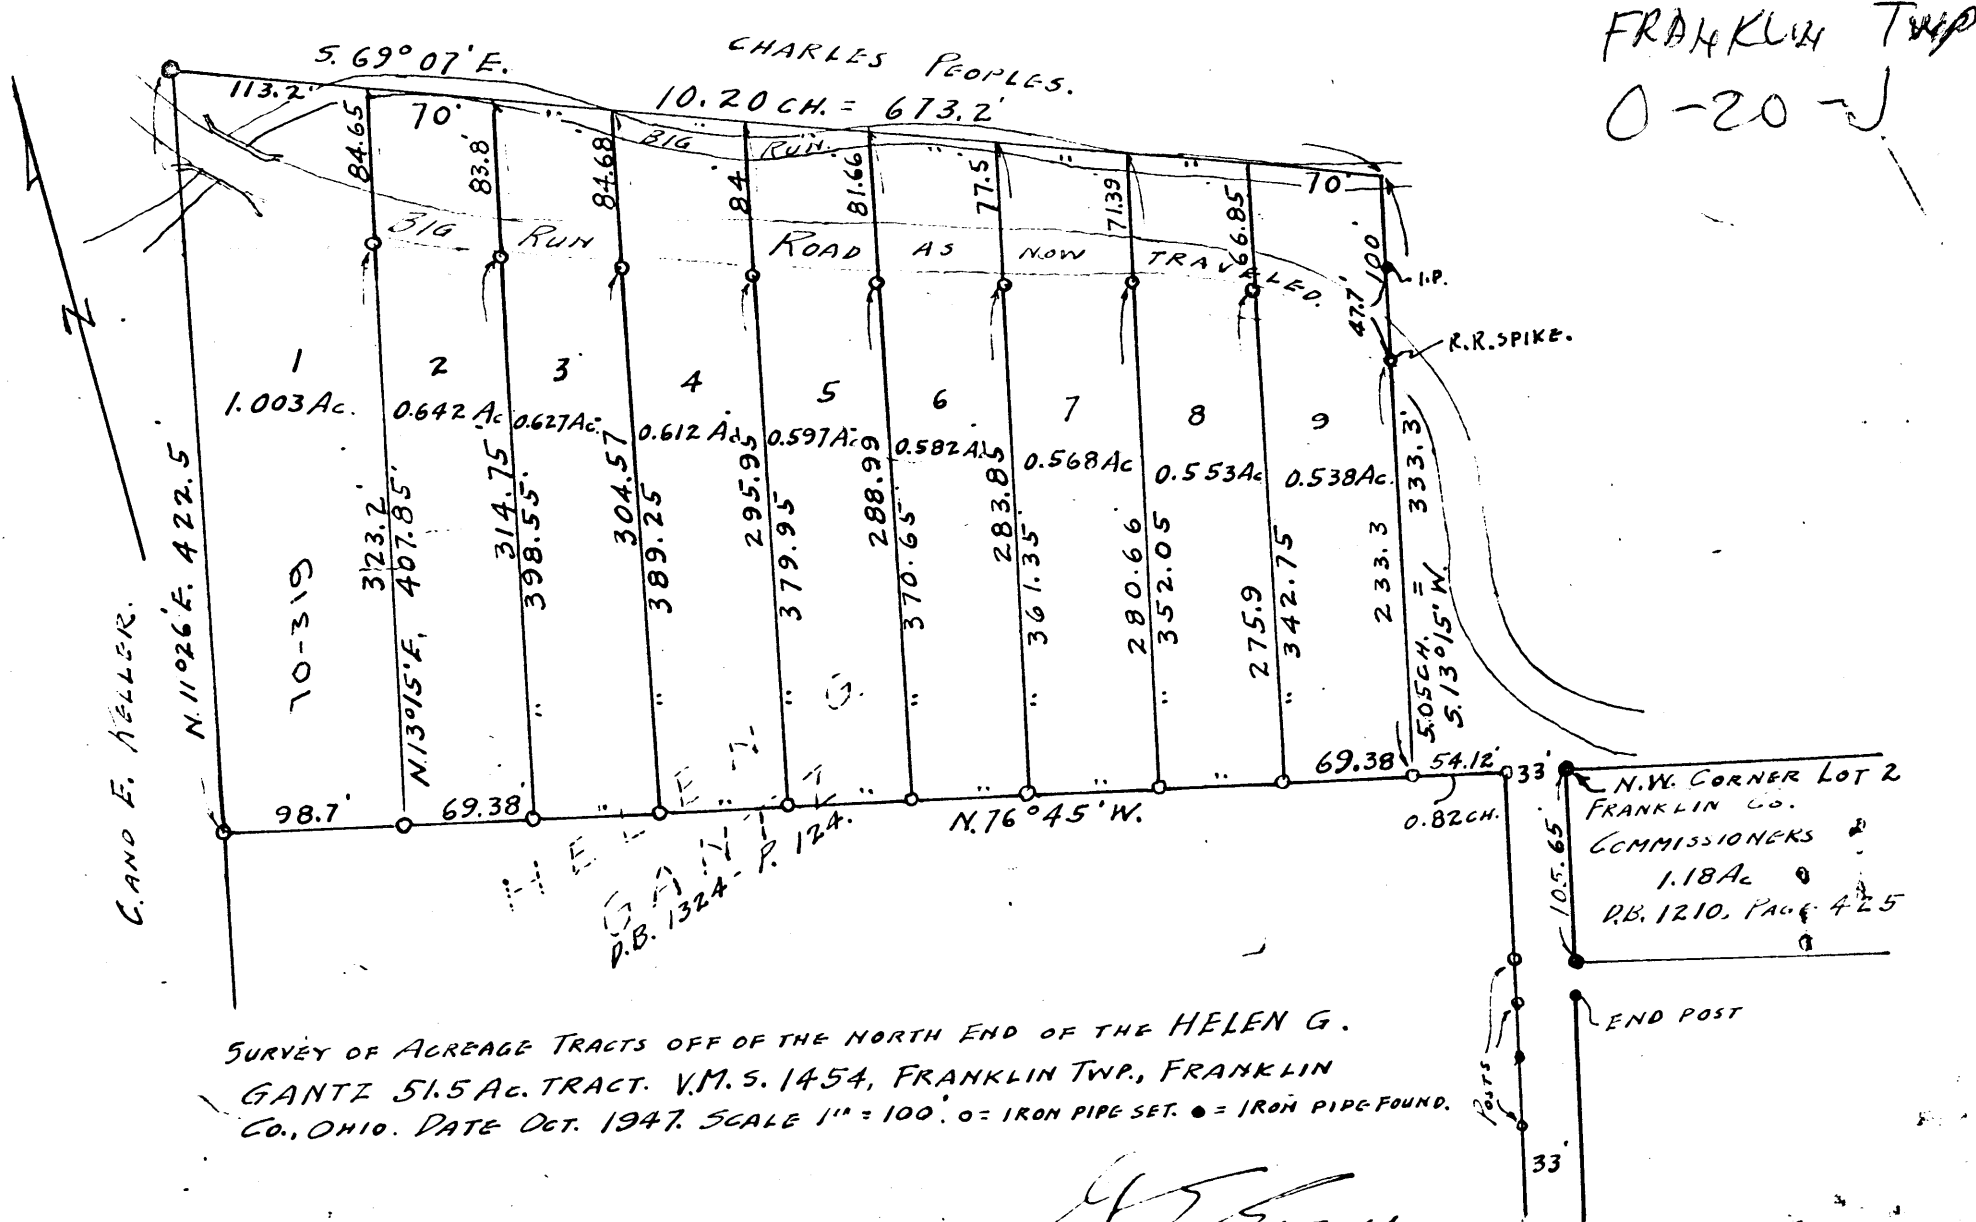

0310 120 012 062 S BIG RUN ROAD 1000 0209 03