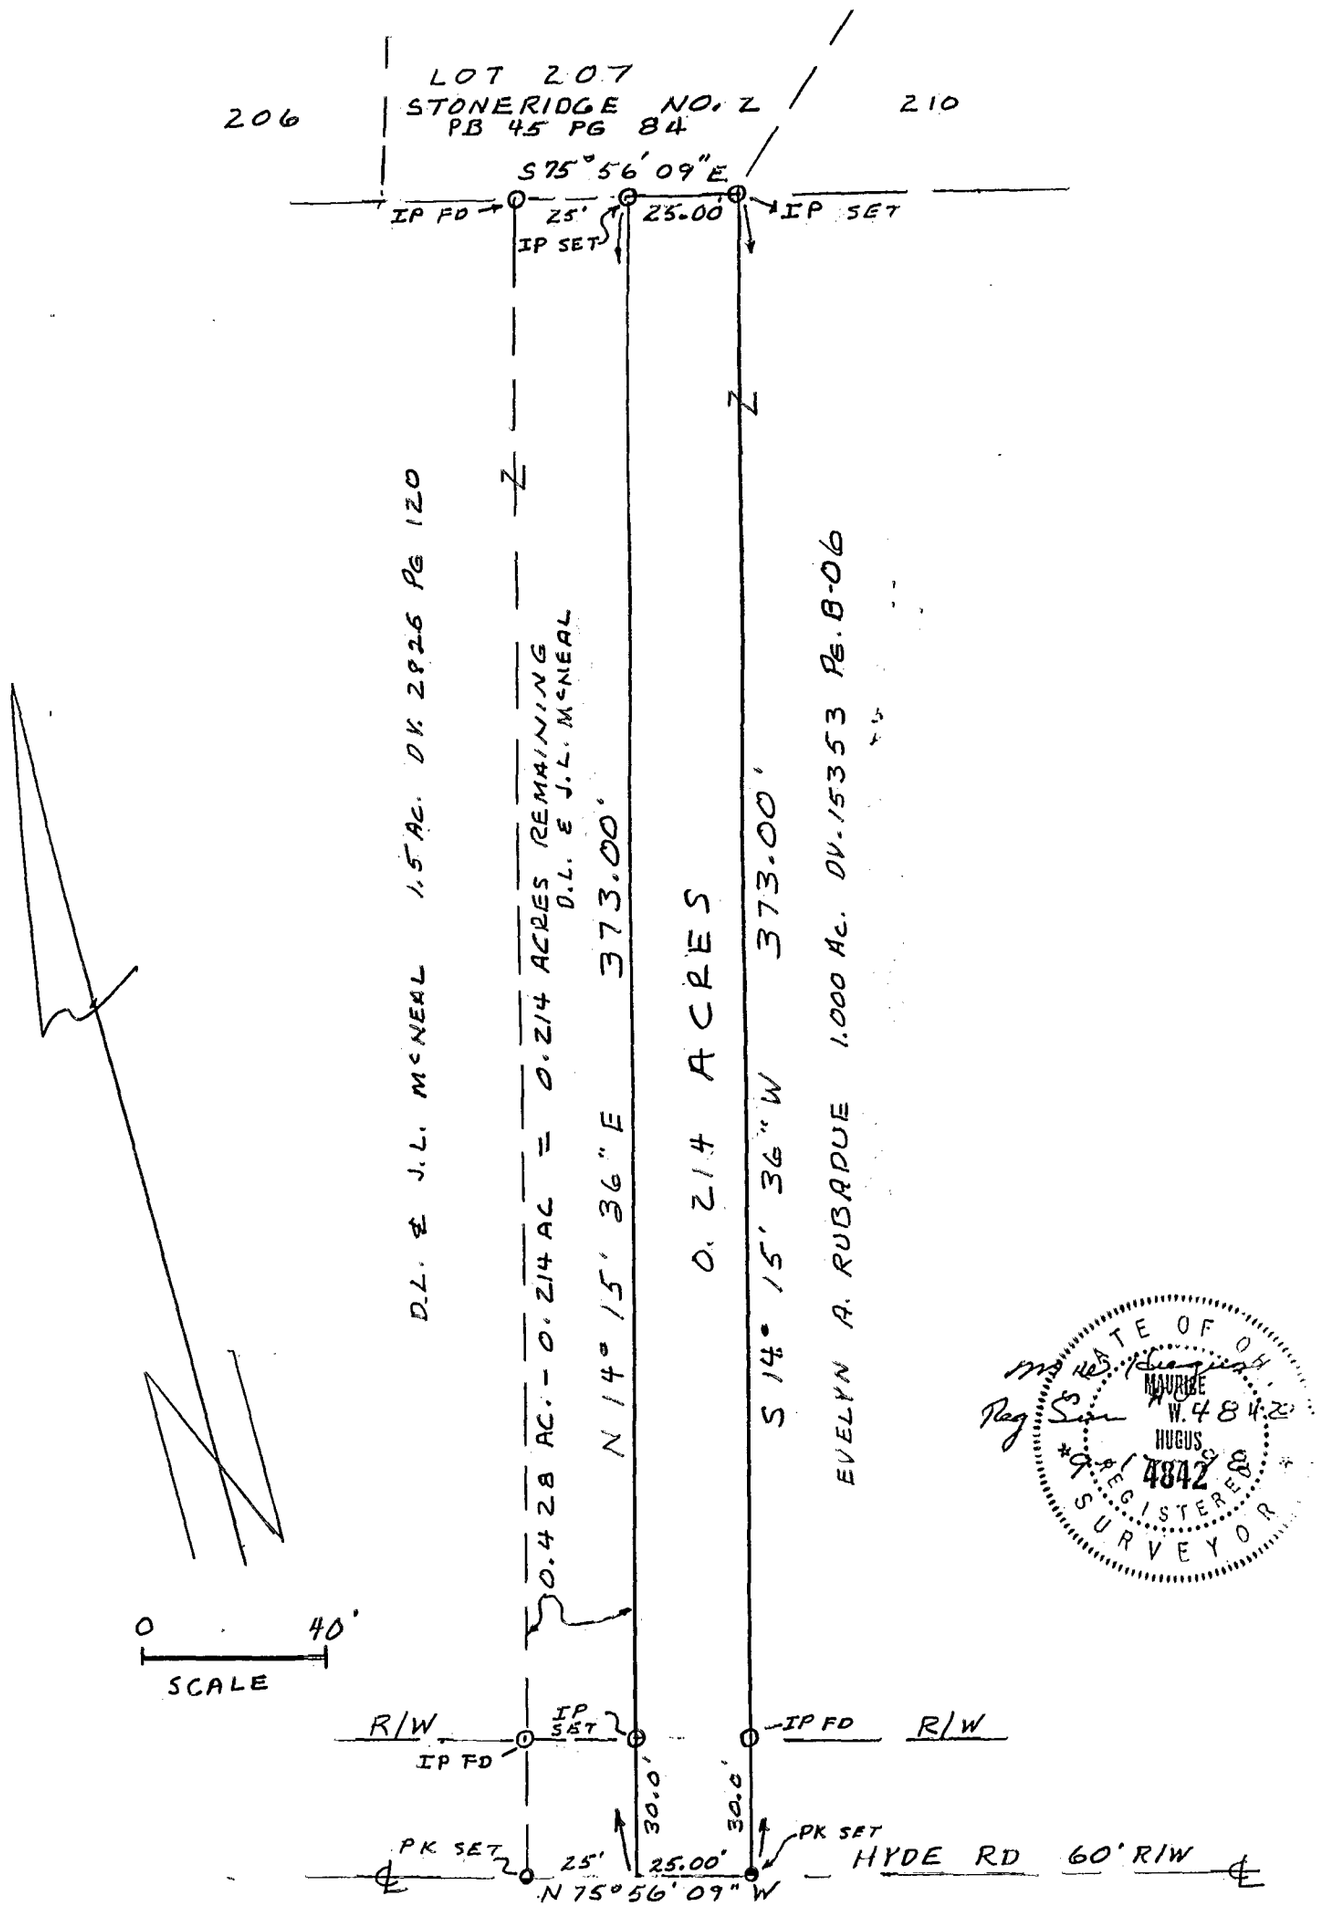

STATE OF OHIO
MAURICE W. HUGUS
4842
REGISTERED SURVEYOR

SURVEY PLAT

Showing the Easterly 25 foot wide strip of ground out of a 50 foot wide strip of ground out of a 0.428 acre tract in VMS. # 1454 , City of Columbus , Franklin County, Ohio as said 0.428 acres is recorded in Inst. # 199808240213667.

Surveyed for : D.L. & J.L. McNeal 9 - 16 - 98 Scale : 1" = 40'
Surveyed by : M.W.Hugus Reg. Sur. # 4842

o = Iron Pins found or set ● = PK nails set

Bearing S 75° 56' 09" E taken from Inst. # 199808240213667
This plat prepared from an actual field survey by : M.W.Hugus - Reg.Sur. # 4842

PARCEL No. 570-105956

80 856 950