


HYDE LAND SURVEYING

5648 BEECHER ROAD
 GRANVILLE, OHIO 43023
 (614)-927-0732 FAX (614)-964-6309

BEING 0.991 ACRES OUT OF A 6.757 ACRE TRACT AND PART OF LOT 468 OF GIBSON ADDITION (P.B. 19, PG. 33), CONVEYED TO ROBERT E. FRITZ IN DEED VOL. 3156, PAGE 544, IN LOT 145 VIRGINIA MILITARY SURVEY 717, IN THE CITY OF COLUMBUS, COUNTY OF FRANKLIN, STATE OF OHIO.

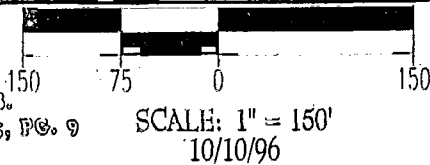

FLOOD ZONE DETERMINATION:

ZONE "X" F.I.R.M. 390170-0245 G
 AUGUST 02, 1995




BASIS OF BEARINGS FOR THIS SURVEY IS THE NORTH LINE OF JOHN D. SCHWENKER'S 1.053 ACRE TRACT AS N 68°31'30" W RECORDED IN OFFICIAL RECORD VOL. 19642 E20.

IRON PIN SET = ○

IRON PIN FOUND = ⊙

REBAR FOUND = ●

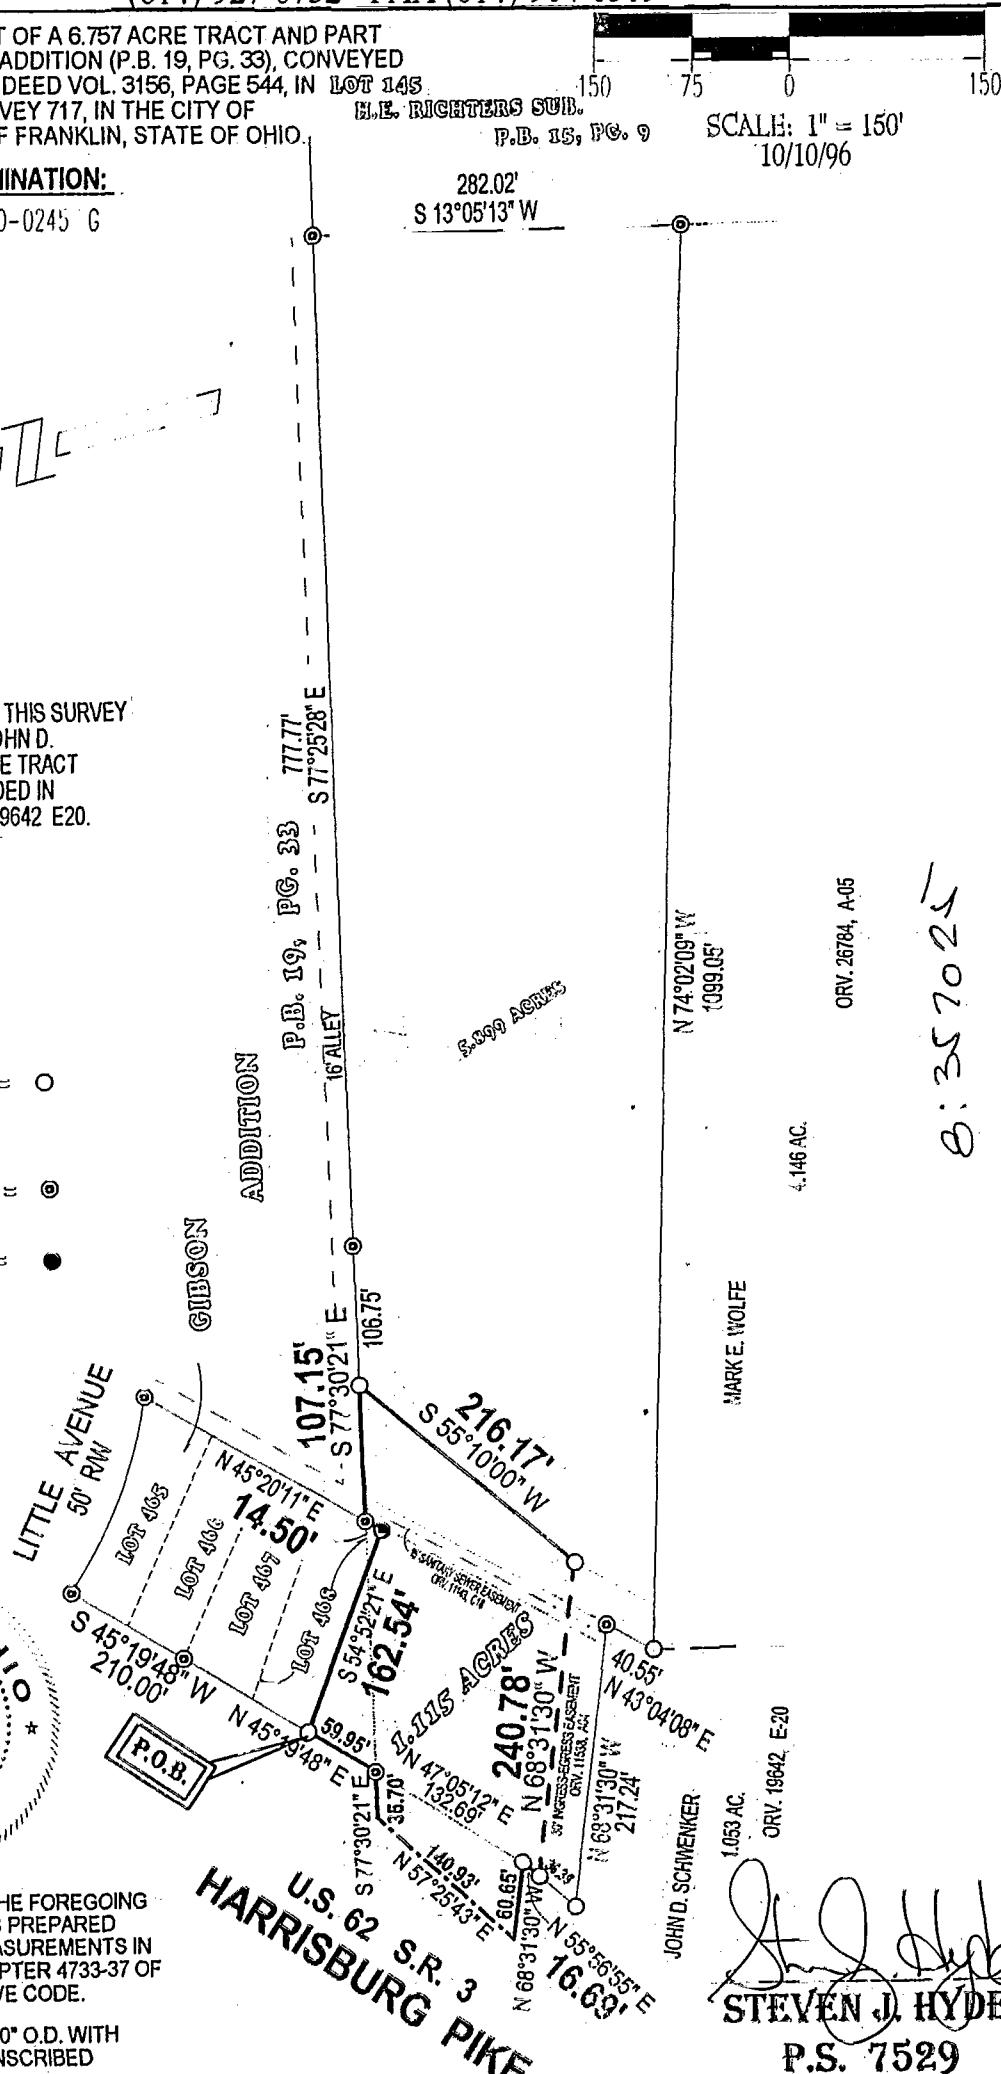

I HEREBY CERTIFY THAT THE FOREGOING BOUNDARY SURVEY WAS PREPARED FROM ACTUAL FIELD MEASUREMENTS IN ACCORDANCE WITH CHAPTER 4733-37 OF THE OHIO ADMINISTRATIVE CODE.

IRON PINS SET ARE 1" X 30" O.D. WITH YELLOW PLASTIC CAPS INSCRIBED "HYDE P.S. 7529".

U.S. 62 S.R. 3
HARRISBURG PIKE

STEVEN J. HYDE
 P.S. 7529

B: 357025

