

0-22-E  
FRANKLIN Twp

# Myers Surveying Company, Inc.



2740 East Main Street, Columbus 43209 (Bexley), Ohio  
614-235-8677 FAX: 614-235-4559

A Boundary Survey prepared for and certified to:  
**Ranft Realty Holding Co. Ltd.**

Legal Description: Situated in Ohio, County of Franklin, Township of Franklin, Being 12.990 Acres, Part of Virginia Military Survey No. 717, being all of the 7.064 Acres, 5.899 Acres, and 0.061 Acres, conveyed to Ranft Realty Holding Co. Ltd. (Instrument # 200003280059811, Instrument # 200003030043708 and Instrument # 200103150053015)

Applicant:  
Posted Address: Harrisburg Pike

## HARRISBURG PIKE

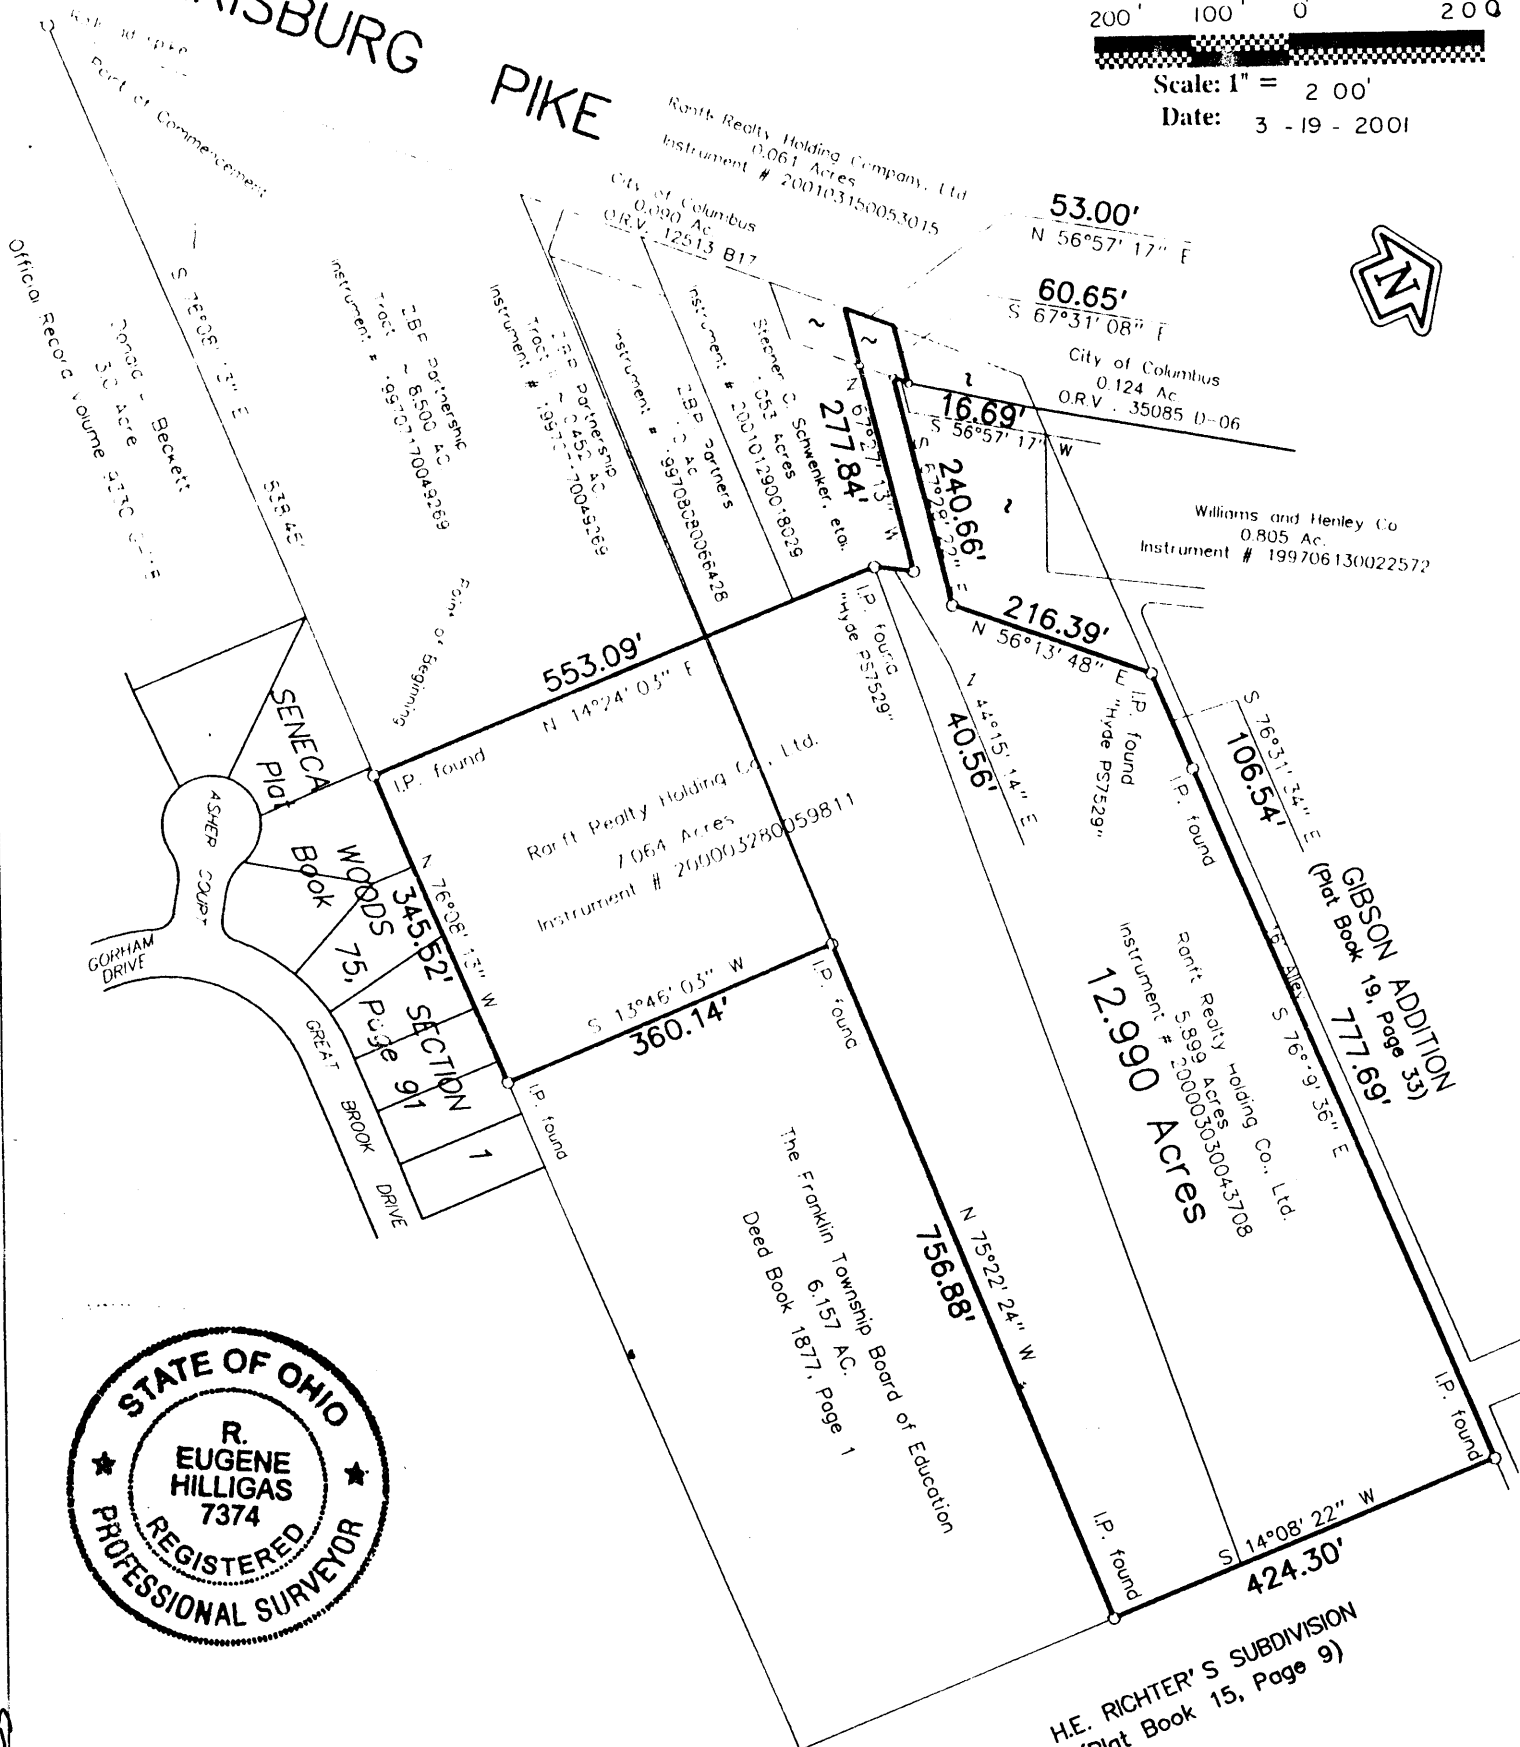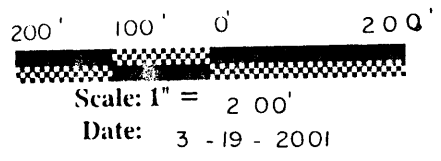

01357025

We hereby certify that the foregoing Boundary Survey was prepared from actual field measurements in accordance with Chapter 4733-37 Ohio Administrative Code. Iron pins set are 30"x1" O.D. with an orange plastic plug inscribed "P.S. 6579", unless otherwise noted. Basis of bearing is the centerline of Harrisburg Pike held as North 56 degrees 57 minutes 17 seconds East as per Instrument Number 200103150053015.

Myers Surveying Co., Inc.  
By *R. Eugene Hilligas*  
Professional Surveyor

Myers Order No. - 7-01/23/01	Rec.	Field	DWG	Ltr.	Ck.
------------------------------	------	-------	-----	------	-----