


FRANKLIN TWP  
0-22-A

0-22-A

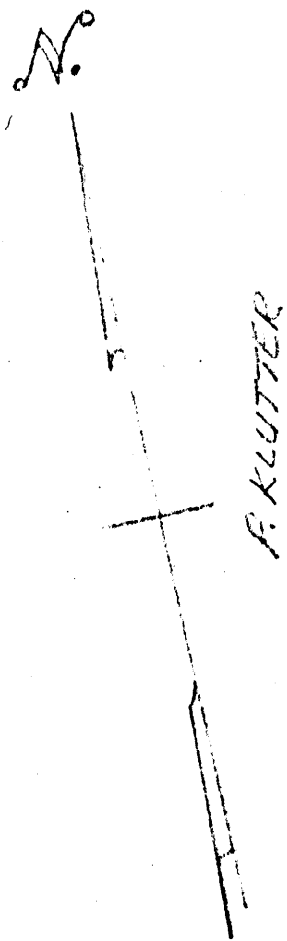

SCALE: 1" = 40'

○ = IRON PIPE FOUND  
○ = IRON PIPE SET

FEB. 17, 1973

N. 12°57'E - 344.35'

S. 76°58'53"E.  
107.00'

0.848 ACRE

PART PARCEL #105104

S. 12°57'W - 345.93'

N. 76°08'20"W.  
107.00'

EAKIN ROAD 50'

H.E. PATRIDGE

360± TO HARRISB  
PIKE

SURVEY OF 0.848 OF AN ACRE  
PART OF VIRGINIA MILITARY SURVEY #717  
CITY OF COLUMBUS, OHIO

~ SURVEYED FOR ~  
ELIZABETH W. DOWNING - OWNER  
2050 EAKIN ROAD  
COLUMBUS, OHIO 43223

81357025

1370 129 072 035 N EAKIN RD 1000 0221 03

*Robert J. Downing*  
R T PATRIDGE & ASSOCIATES  
4466 DUBLIN ROAD