THE THOMAS ENGINEERING & SURVEYING COMPANY

3203 WEST BROAD STREET — COLUMBUS 4, OHIO

ORDER NO. 893-51 FRANKLIN TWP. 0-22-G

Plat of
Survey of William F. and Tillie Fleming Farm, Franklin Township
For
William F. & Tillie Fleming

SCALE 1" = 300'
AUGUST 5, 1951

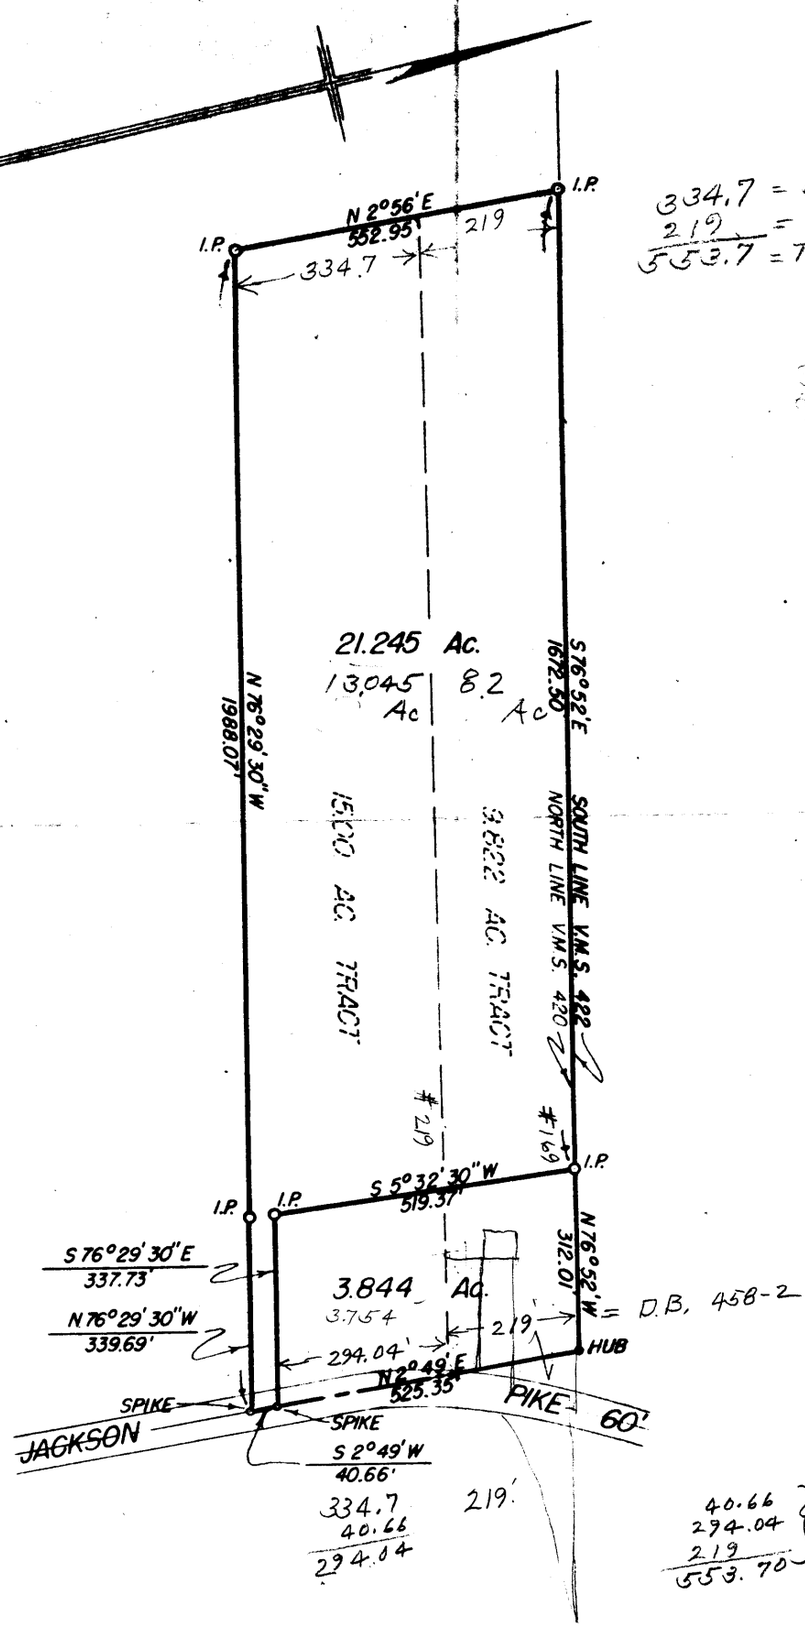

We hereby certify that the foregoing drawing was prepared from an actual survey of the premises and correctly shows the location of the boundaries.

THE THOMAS ENGINEERING & SURVEYING CO.

Checked by Drawn by

Registered

0-22-G

2450 120 064 062 W HARMON AVE 1851 0227 03