


0.224

PLAT SHOWING PART OF A 25 ACRE TRACT OFF BROWN ROAD FOR HENRY E. HUFFMAN 71-287

SCALE 1" = 200'
JULY 1956

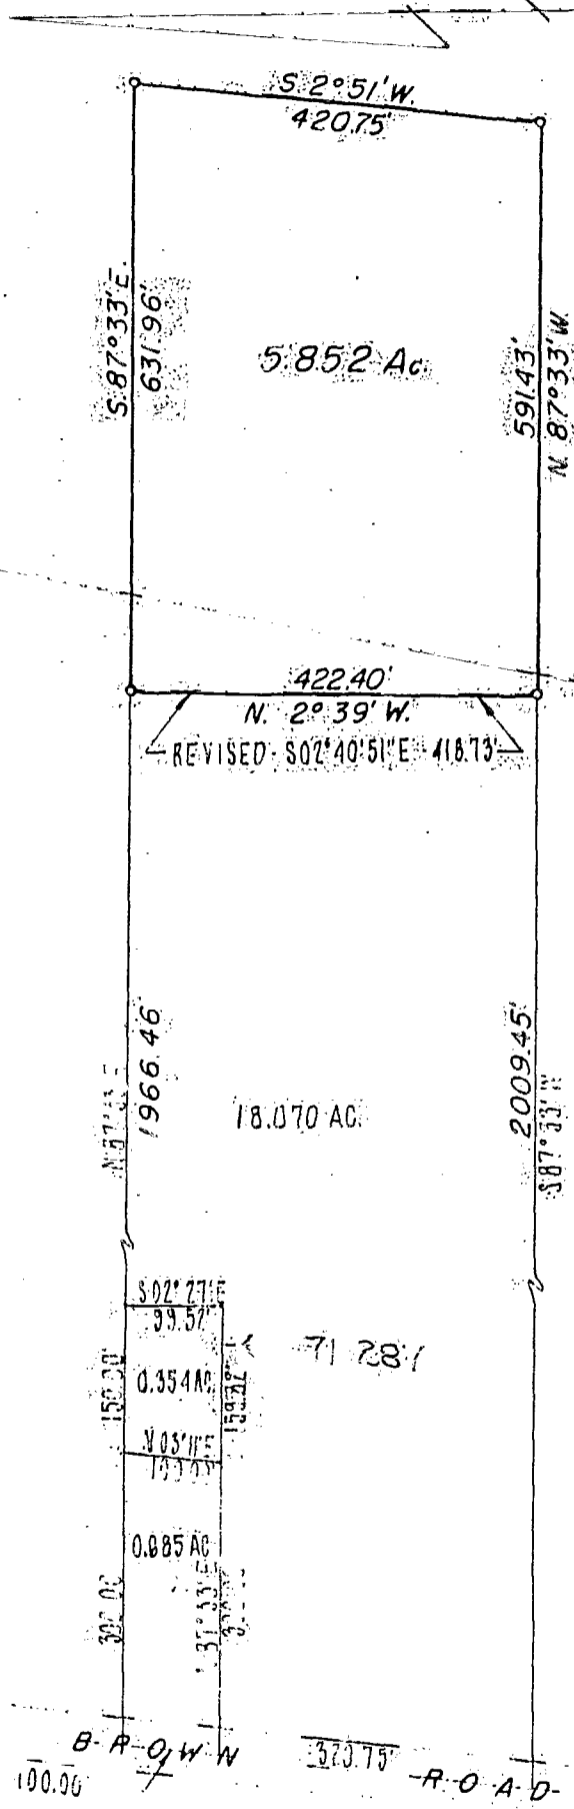

03
0226
1956
RD
065085
120
5100

FRANKLIN 7-22-56

8.607035
8.957025
8.957000

REVISED MAP 72
ORDER NO. 494

THE THOMAS ENGINEERING COMPANY
REGISTERED SURVEYORS

Checked by _____ Drawn by EBY

THE THOMAS ENGINEERING COMPANY