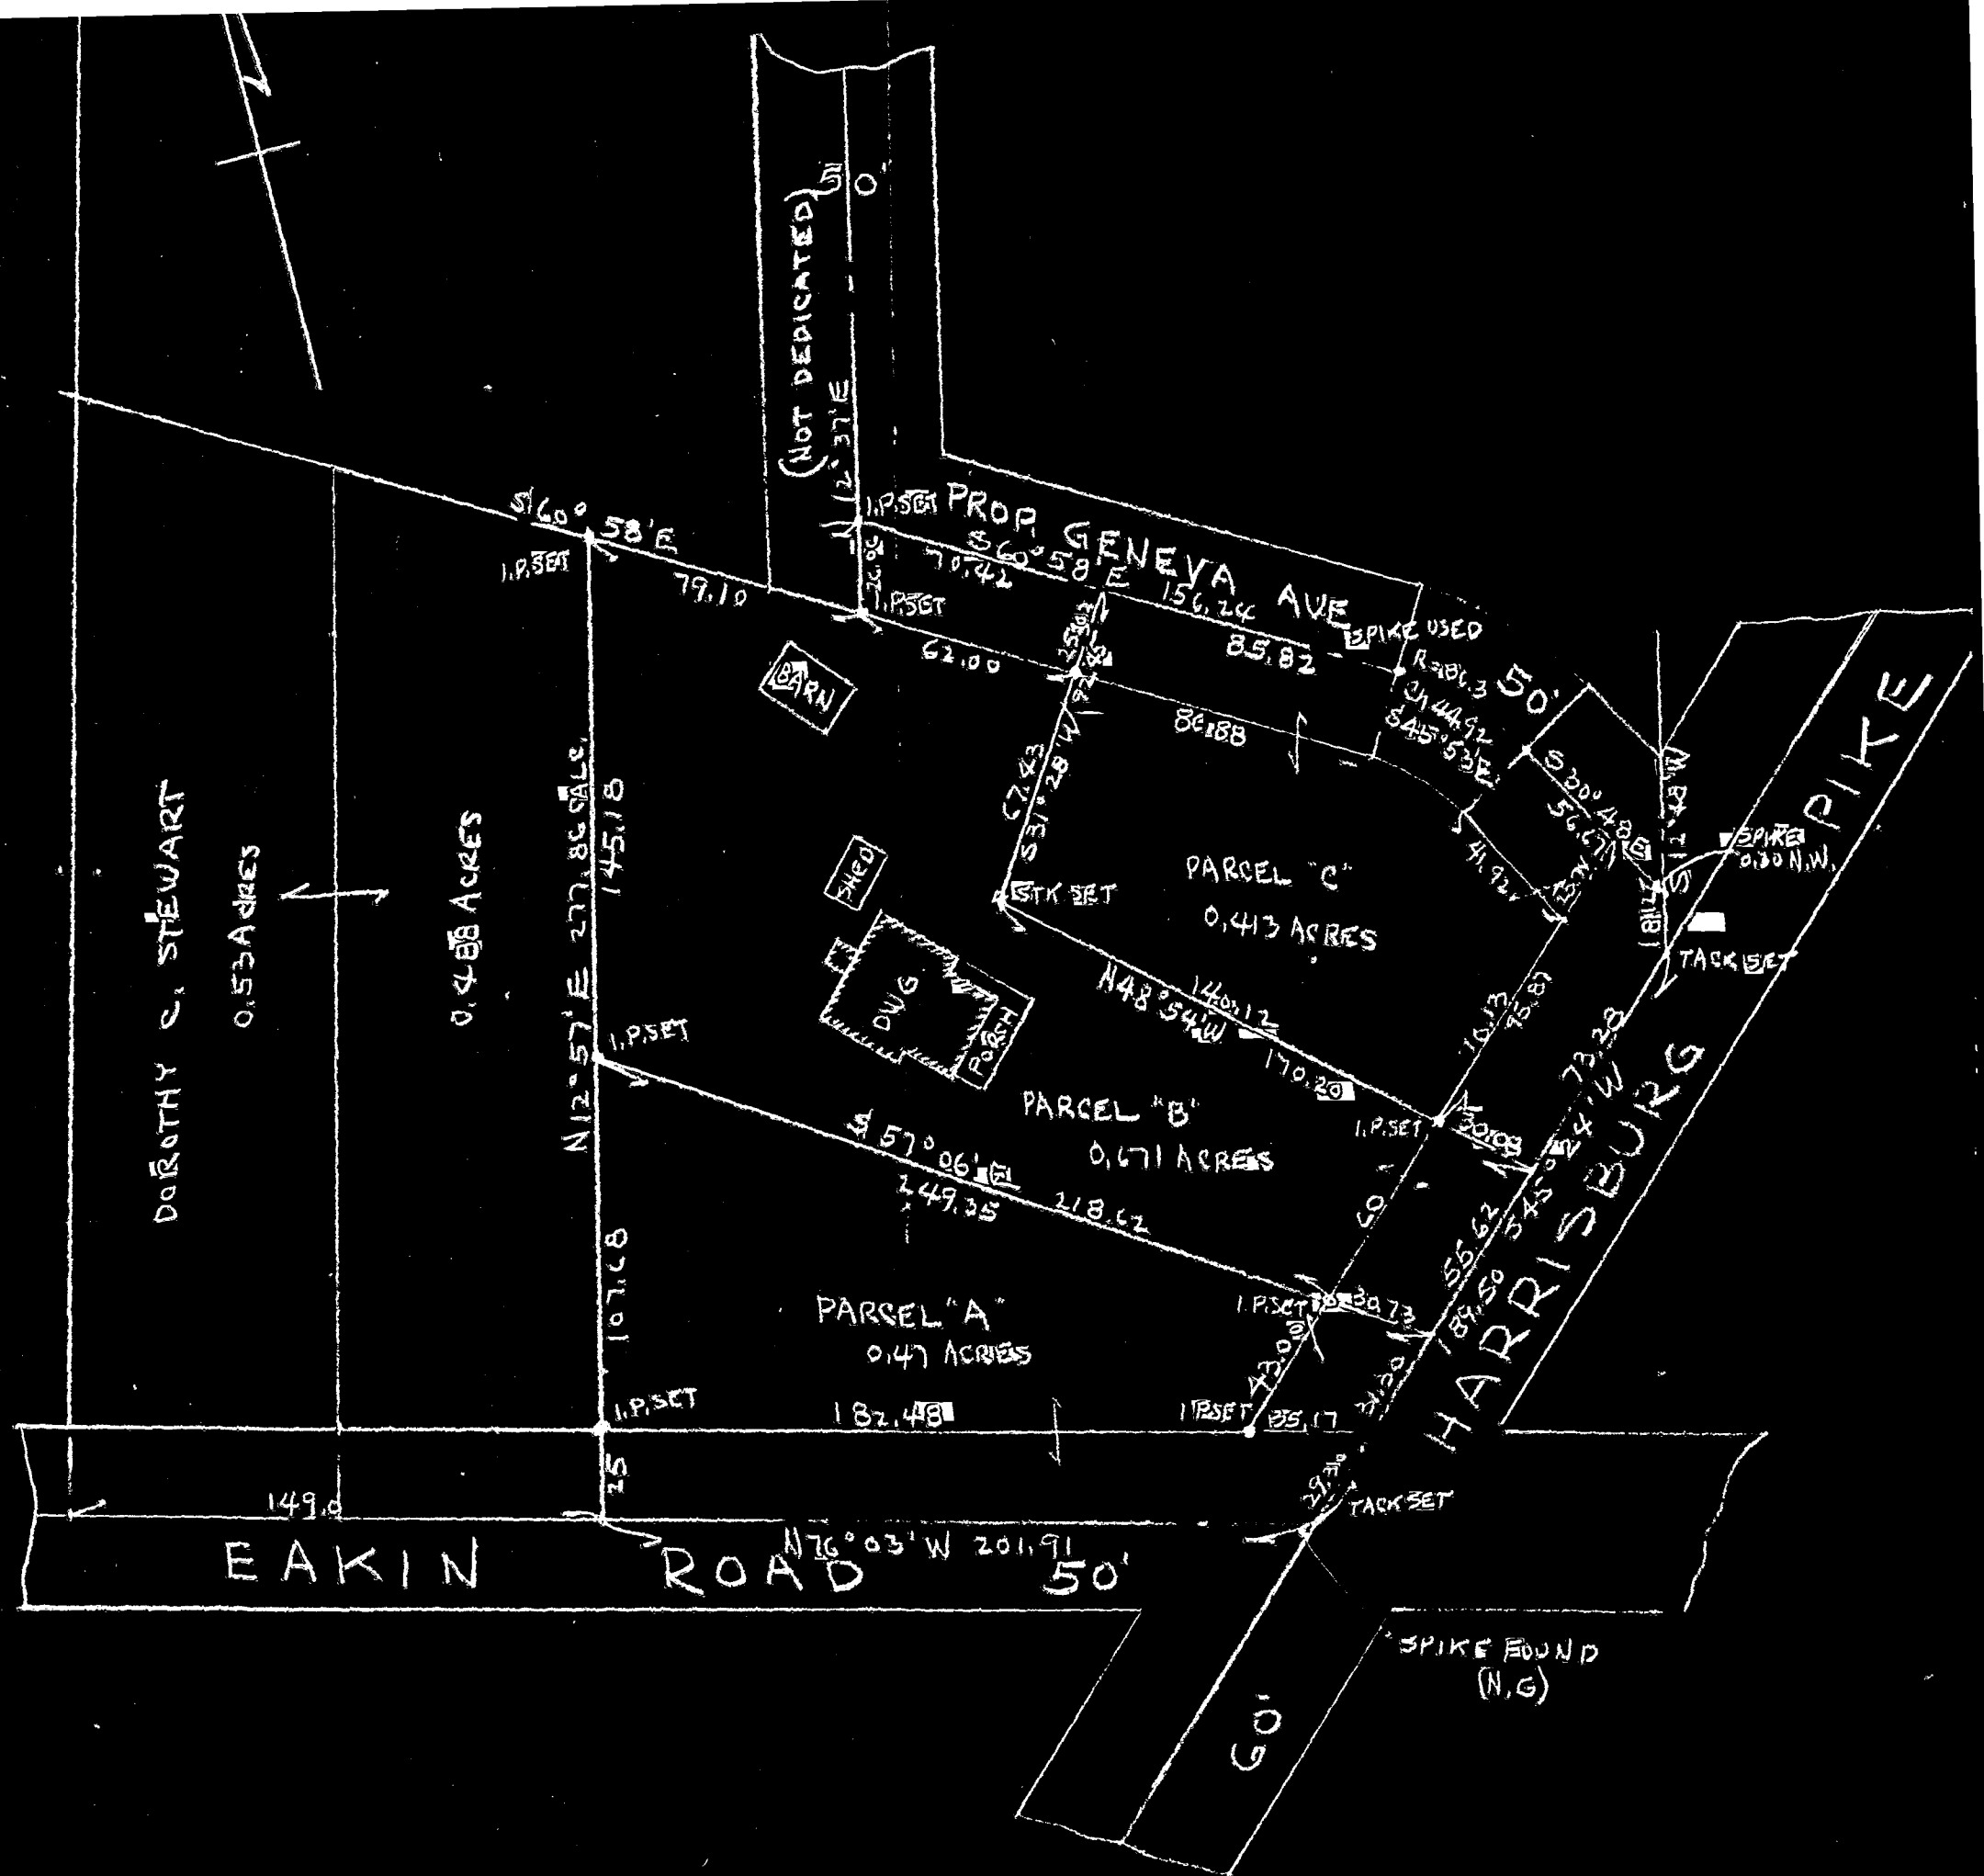

SURVEY FOR
MABEL NORMAN

OF PARCELS A, B & C AS SHOWN HEREON, BEING PART OF A 1.56 ACRE TRACT IN FRANKLIN TWP., FRANKLIN COUNTY, OHIO IN MILITARY SURVEY NO 717.
I DO HEREBY CERTIFY THIS SURVEY TO BE CORRECT

Myron D. Jones, Surveyor

SCALE 1" = 50'

MAY 1946

1372 122 066 033 N EAKIN W SR 5 1976 0221 03