

Property Survey


Partly in Township of Franklin, Partly in City of Columbus
 Survey 422 VIRGINIA MILITARY LANDS
 Part of Lot 1 & 2, Wm. L. Miner's Subdivision

0-0-0

DATE: 1-19-88 REVISED: 2-1-88
 SCALE: 1" = 60' 3-23-88

○ = IRON PIN SET
 ● = IRON PIN FOUND
 ⊙ = PUNCH HOLE IN CONCRETE

PLAT BOOK 2, PAGE 180

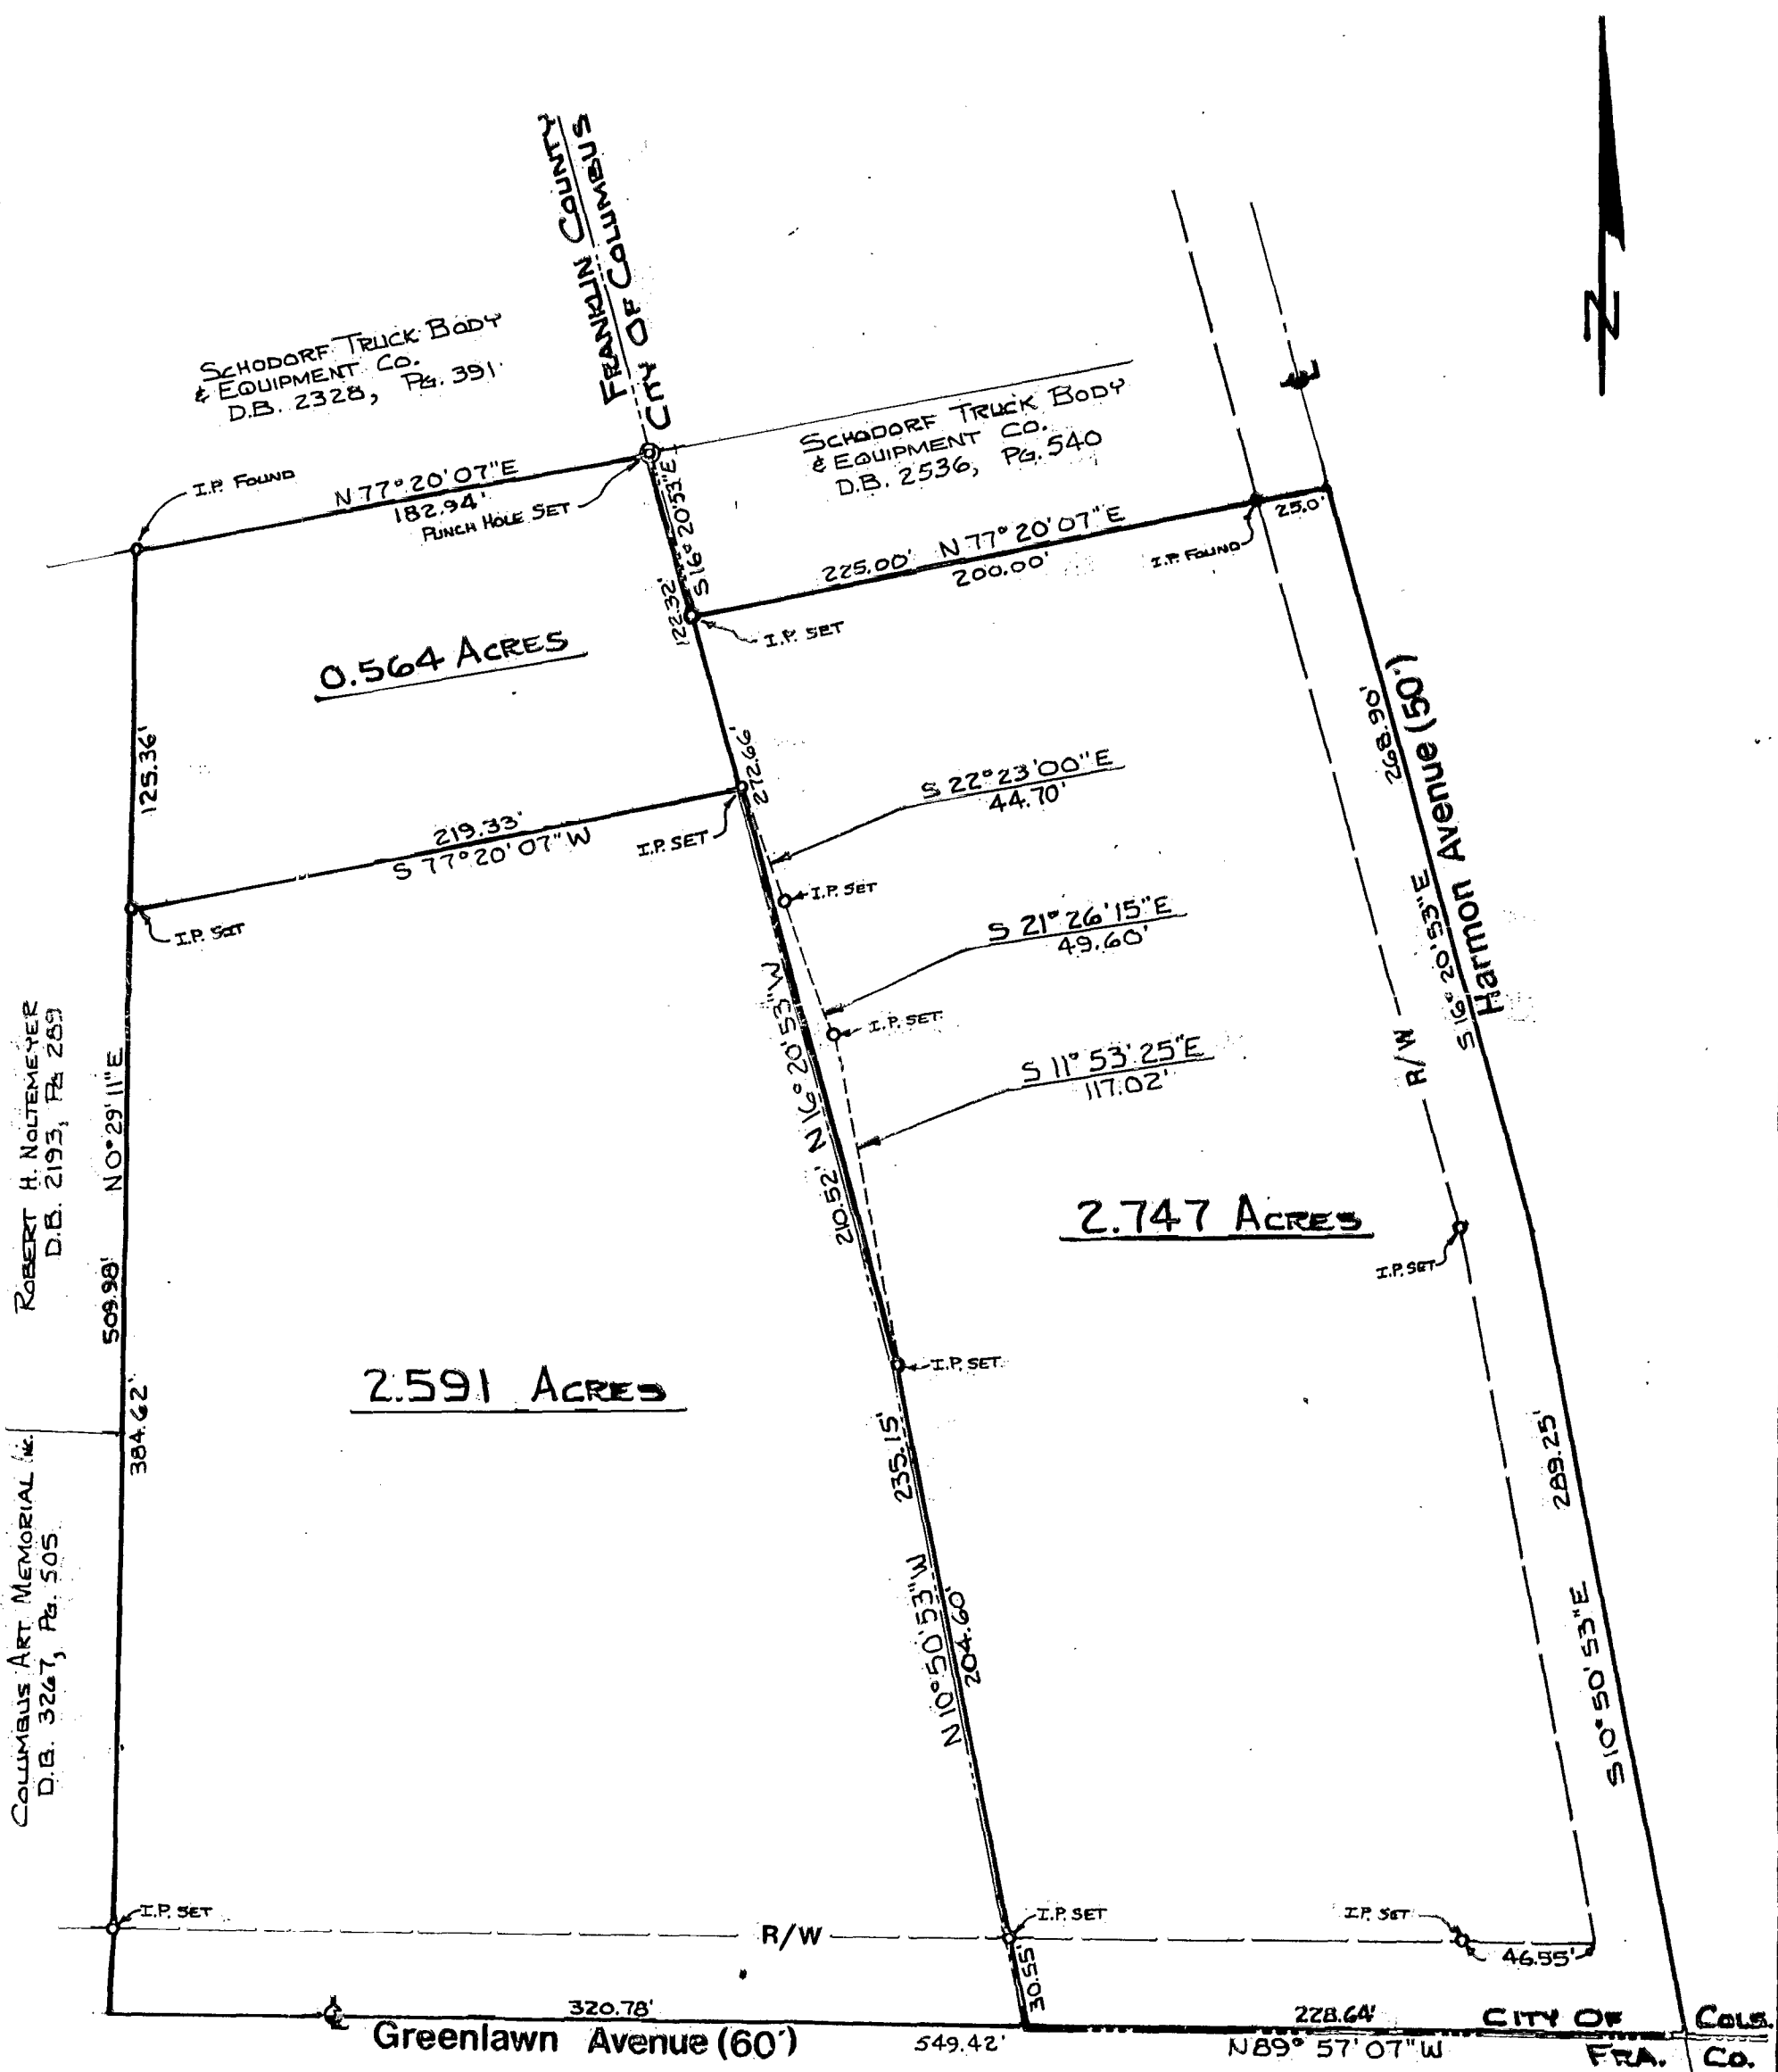

EASEMENTS: DEED BOOK 915, PAGE 227

- 1- ELECTRIC AND TELEPHONE POLES AND WIRES ALONG THE NORTH PROPERTY LINE OF THE COLUMBUS CEMETERY ASSOCIATION.
- 2- WATER SERVICE - BLANKET EASEMENT.

Roger D. Willis

Registered Surveyor No. 5365
 ROGER D. WILLIS