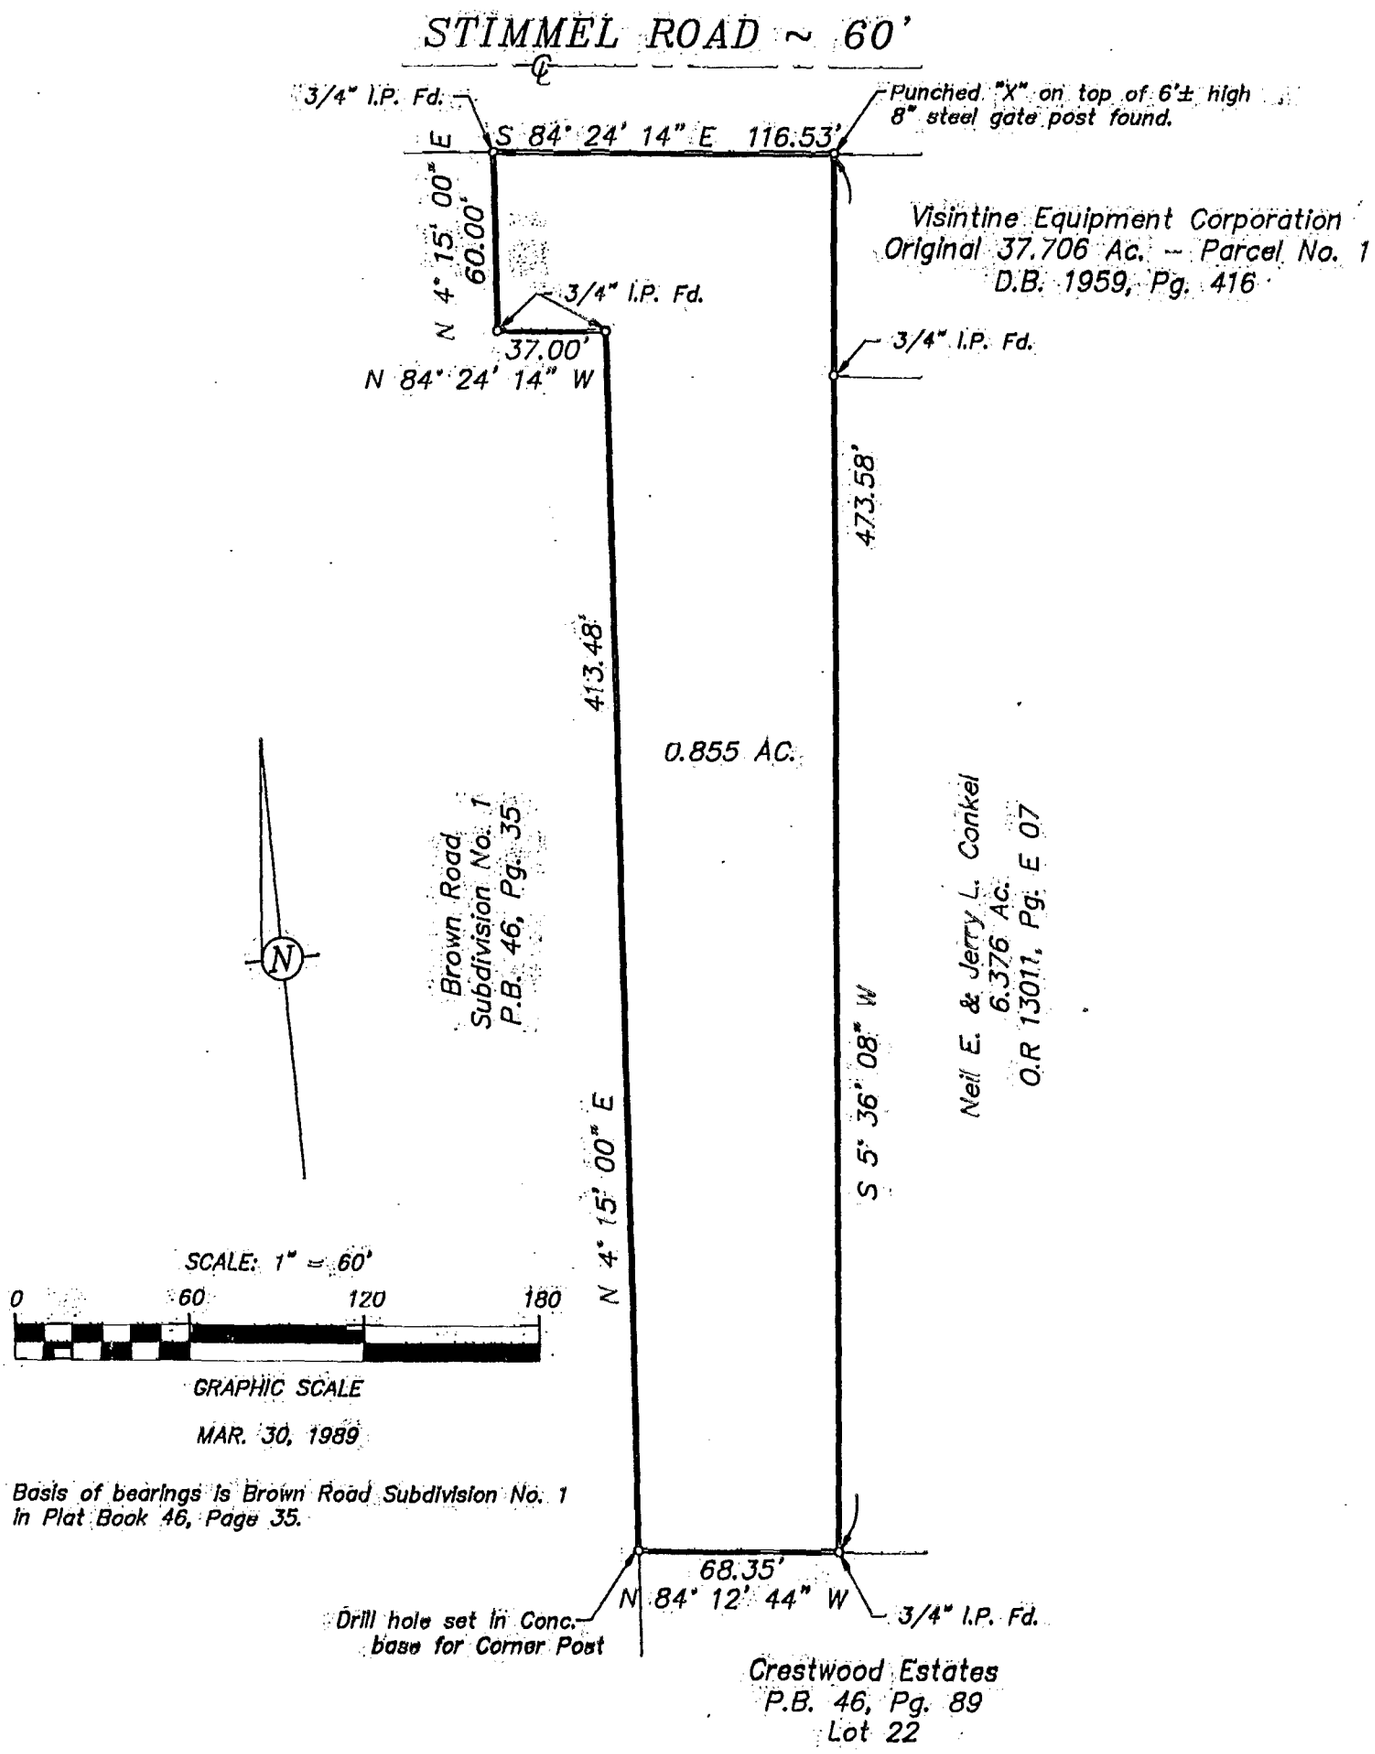

SURVEY OF 0.855 AC. IN V.M.S. 717
EAST OF BROWN RD. &
SOUTH OF STIMMEL RD.,
COLUMBUS, OHIO
FOR
SISSON-STERN COMPANIES, LTD.

TEDDY LAYDON ROBINSON No. S-5361 REGISTERED SURVEYOR

C.F. Bird & R.J. Bull, Inc.
2875 W. Dublin-Granville Road
Worthington, Ohio 43235

By Ted L. Robinson
Ted L. Robinson ~ Ohio Surveyor No. 5361

89-139

FRANKLIN COUNTY

0857025