


FRANKLIN TWP.
6-22-F

BASIS OF BEARINGS -
PREVIOUS SURVEYS

PROPOSED 8.649 AC.
TO BE CONVEYED TO
NEIL CONKEL

34

RANSBURGH
SECOND
ADDITION
(P.B. 22, P. 68)

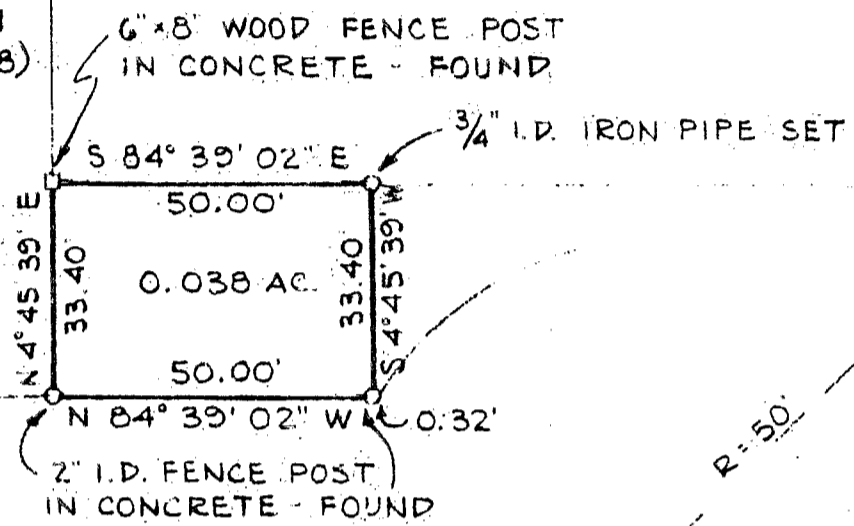

50'

HOPKINS AVE.

RANSBURGH SECOND
ADDITION (P.B. 22, P. 68)

36

35

WILLIAM E. & KATHLEEN M. CANTLEY
D.B. 363, P. 234
4.984 AC.

SURVEY OF 0.038 AC. IN V.M.S. 420, COLUMBUS,
OHIO, FOR VISINTINE EQUIPMENT CORPORATION

SCALE: 1" = 30'

SEPT. 7, 1962

C.F. BIRD & R.J. BULL, LTD.
6113 LINWORTH RD.
DJB WORTHINGTON, OHIO

John P. Wicker Jr.

#6261

SV-8858

This Instrument was prepared by

Daniel J. Igoe, Esquire

1. Name or names of Grantor(s) and marital status.
2. Description of land or interest therein and encumbrances, reservations, and exceptions, if any.
3. Delete whichever is not applicable.

This space for Auditor's Stamp

This space for Recorder's Stamp

8-857025