

FRANKLIN TWP  
0-22-F

# EVANS MECHWART HAMBLETON & TILTON, INC.

CONSULTING ENGINEERS -- SURVEYORS  
GAHANNA, OHIO

0-22-F

## SURVEY OF 2 ACRE TRACT


LOCATED IN VIRGINIA MILITARY SURVEY NO. 420 &  
PART OF LOT NO. 2 (SEE COMP. REC. 144, PAGES 371-382)  
FRANKLIN TOWNSHIP, FRANKLIN COUNTY, OHIO

SCALE 1" = 100'

OCTOBER 13, 1973  
O=IRON PIN

DEED BOOK 1126, PAGE 176  
PLAT BOOK \_\_\_\_\_, PAGE \_\_\_\_\_

4340 120 076 078 E S T I M M E L R D 1973 0226 003

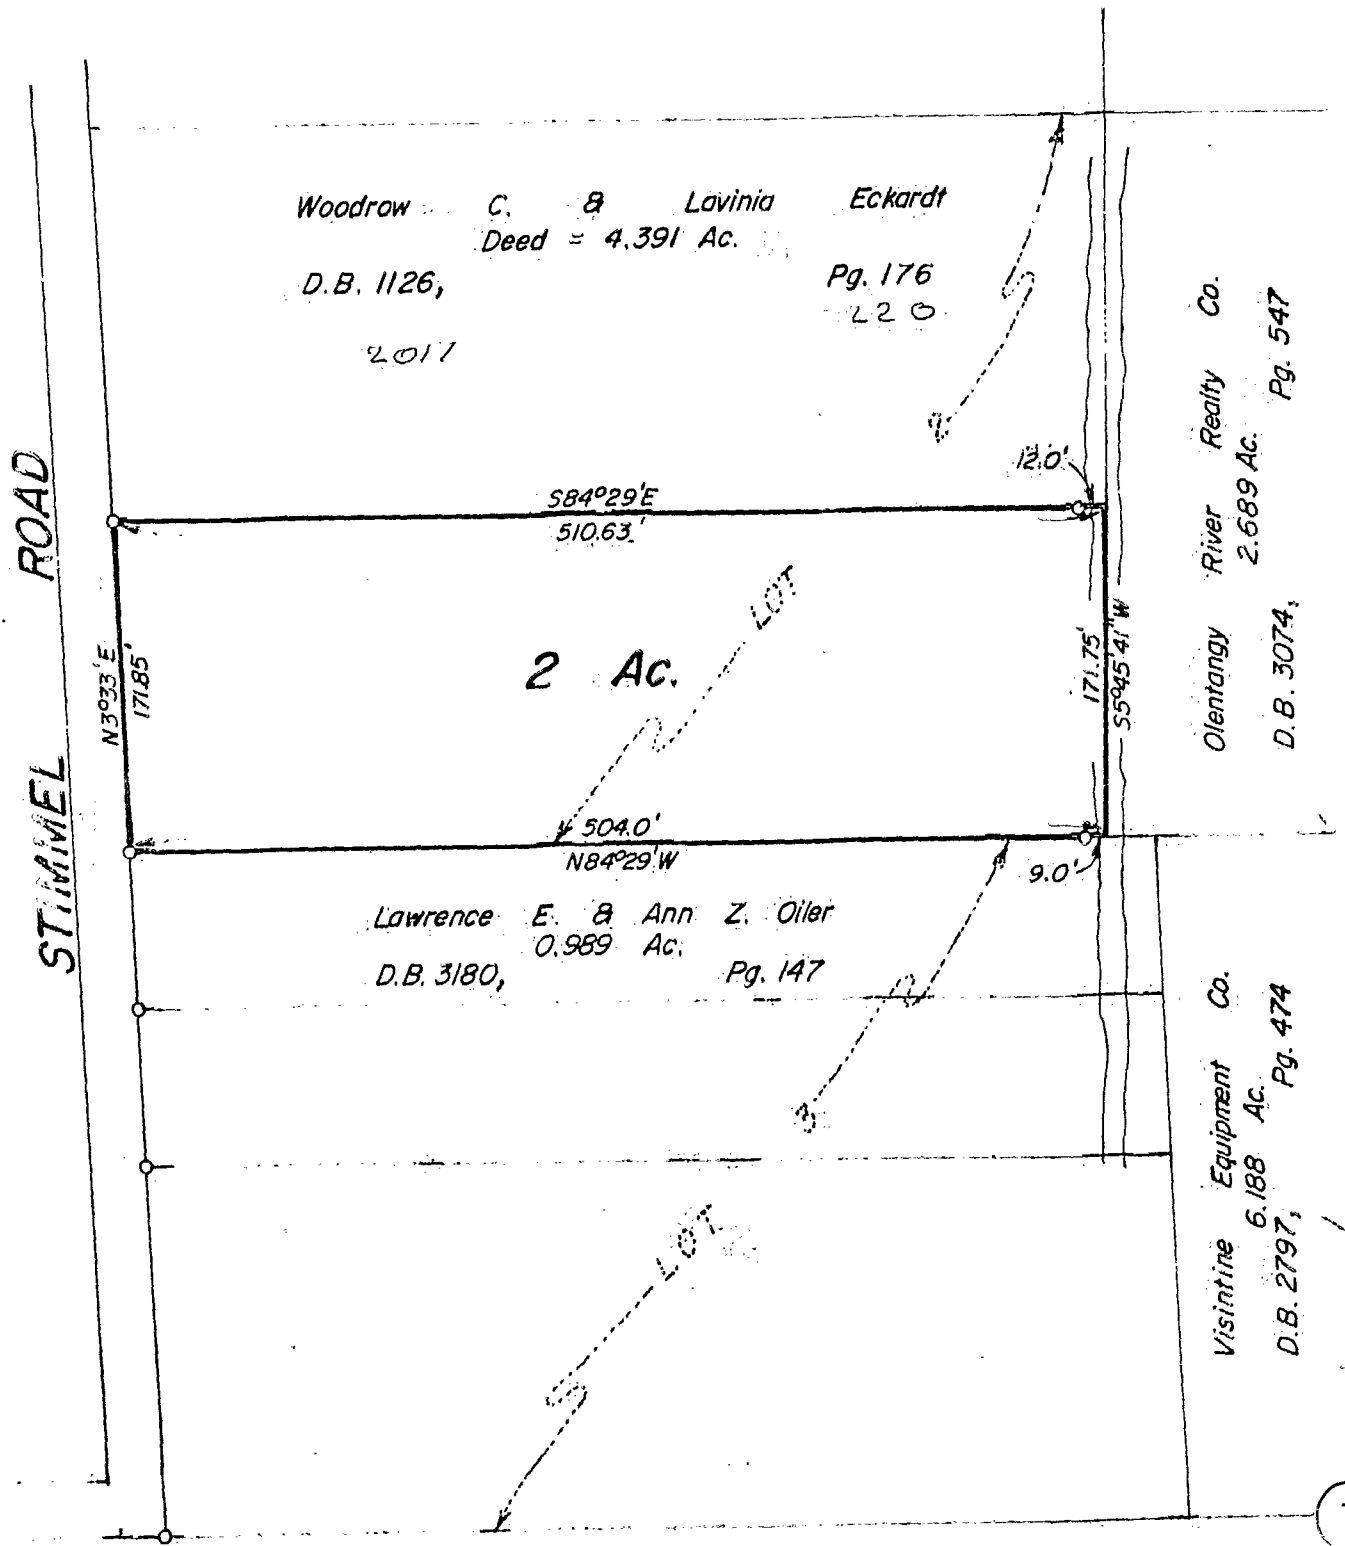

Woodrow C. & Lavinia Eckardt  
Deed = 4.391 Ac.  
D.B. 1126, Pg. 176  
2017 220

Olentangy River Realty Co.  
2.689 Ac.  
D.B. 3074, Pg. 547

Lawrence E. & Ann Z. Oiler  
0.989 Ac.  
D.B. 3180, Pg. 147

Visintine Equipment Co.  
6.188 Ac.  
D.B. 2797, Pg. 474

8.857025

WEH

We hereby certify that the foregoing plat was prepared from an actual survey of the premises and shows the location of the boundaries.

EVANS MECHWART HAMBLETON & TILTON, INC.

BY M. H. Mechwart  
Registered Surveyor No. 4072