


0-22-0
FRANKLIN
TWP



DLZ OHIO, INC.
6121 HUNTLEY ROAD COLUMBUS, OH 43229
PHONE (614) 888-0040 FAX (614) 888-6415

GREENLAWN AVENUE RIGHT-OF-WAY TAKE CITY OF COLUMBUS, OHIO

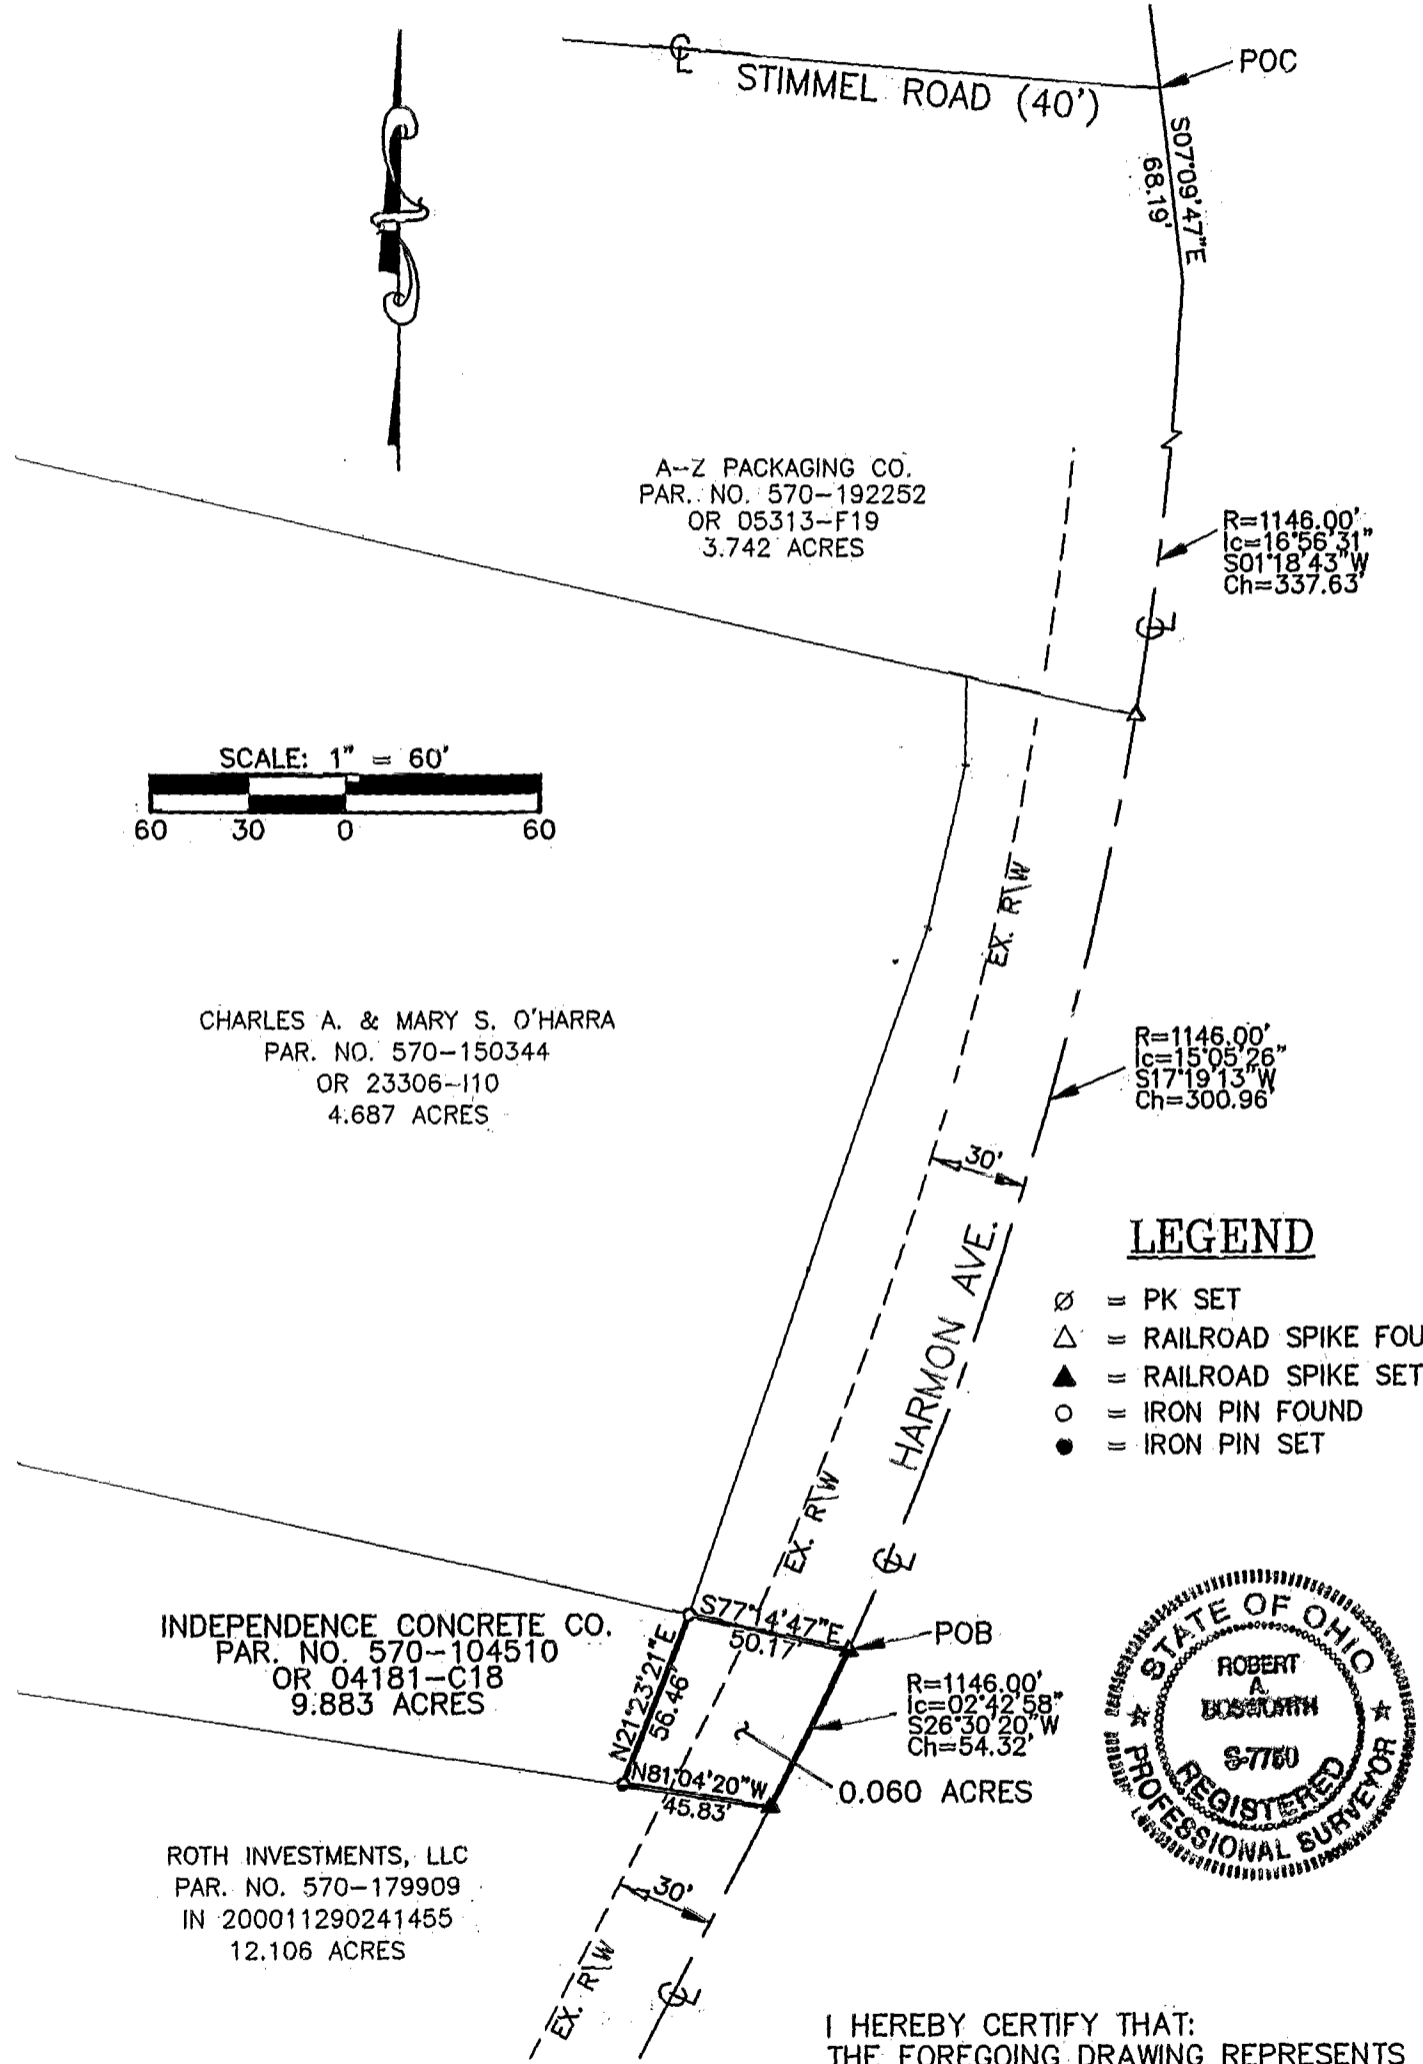

LEGEND

- ⊗ = PK SET
- △ = RAILROAD SPIKE FOUND
- ▲ = RAILROAD SPIKE SET
- = IRON PIN FOUND
- = IRON PIN SET



I HEREBY CERTIFY THAT:
THE FOREGOING DRAWING REPRESENTS THE
RESULTS OF AN ACTUAL FIELD SURVEY OF
THE PREMISES PERFORMED UNDER MY
RESPONSIBLE SUPERVISION AND THAT THE
SAID DRAWING IS CORRECT TO THE BEST
OF MY KNOWLEDGE AND BELIEF.

BASIS OF BEARING:
BEARINGS ARE BASED ON THE OHIO STATE PLANE
COORDINATE SYSTEM, SOUTH ZONE.

82357075

DRAWN:	CHK'D.	PROJECT NUMBER	BY: <i>Robert A. Bosworth</i>	5-30-06
		2221 1015.00	ROBERT A. BOSWORTH, P.S. 7750	DATE: