

18285 10.25

1.32

MYERS SURVEYING CO.

2740 East Main Street, Columbus 43209 (Bexley), Ohio

PART OF LOTS 9, 10, 11, 12 JOSEPH SAUER'S SUB. COLUMBUS, OHIO

For

TRANSOHIO TITLE AGENCY, I N C.

And/or

BANK ONE OF COLUMBUS, N. A.



P.B. 5 Page 84

Scale 1" = 20'

NOT TO BE USED TO ERECT FENCES

Franklin Co. Rec. Office

S. WALL ST. 20'

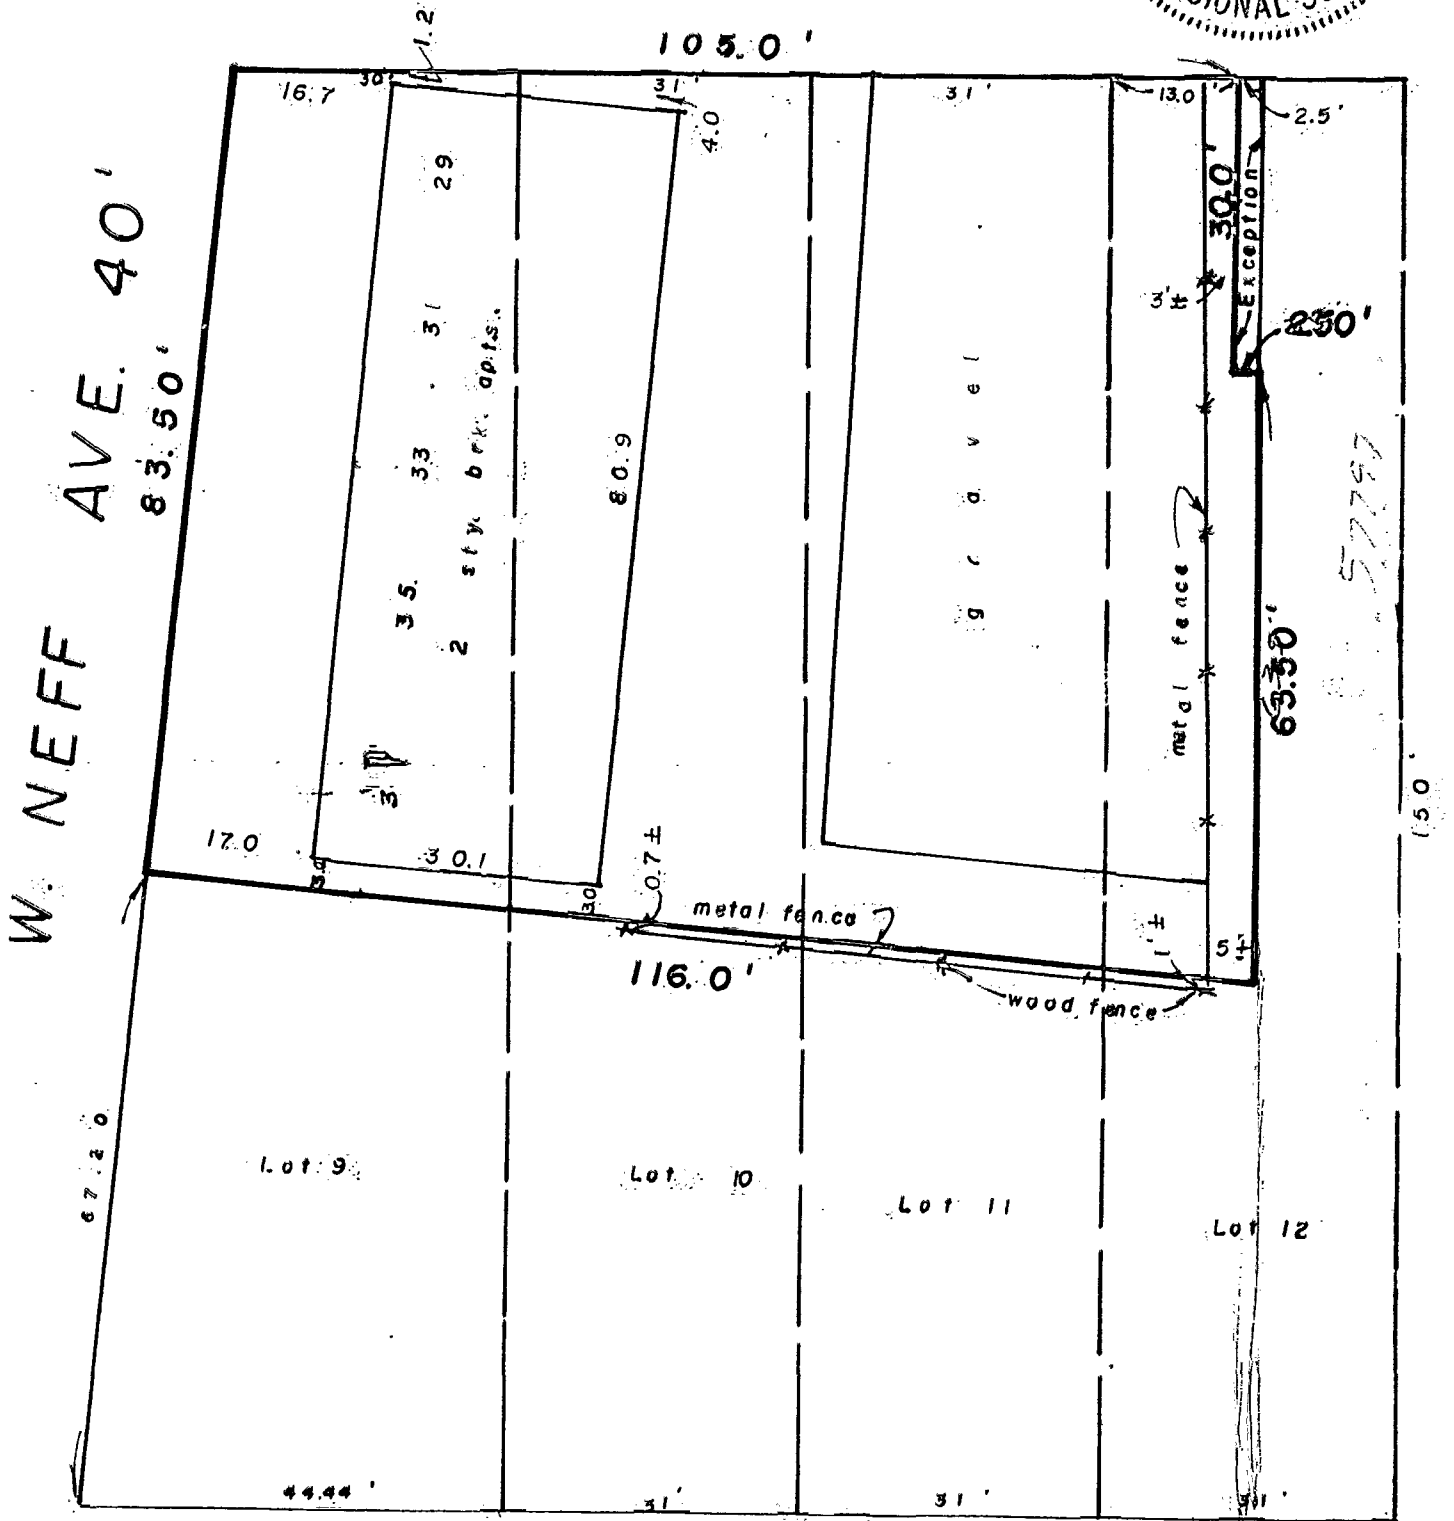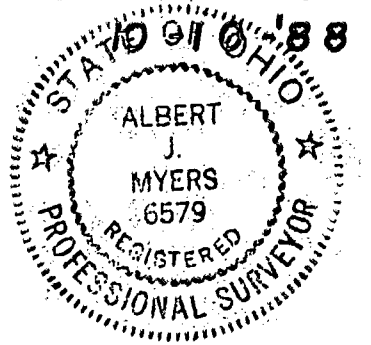

We hereby certify that the foregoing plat was prepared from an actual survey of the premises. No side line of principal building is less than dimension shown. Iron pins not set unless indicated thus -0-. For Mortgage Loan & Title Insurance purposes only.

LEONARD 39 10 7 '88

MYERS SURVEYING CO.

BY Albert Myers
Registered Surveyor