MYERS SURVEYING CO.

2700 East Main Street
COLUMBUS 9 (BEXLEY), OHIO

K-25

PART LOTS 45, 46 DESHLER & THURMAN'S ADDITION
COLUMBUS, OHIO. 182857050 FOR

MR. ALBERT HAWRANEY

Book 1 Page 257
1" = 25'

Franklin Co. Rec. Office
22 FEB., 58

Pg 110

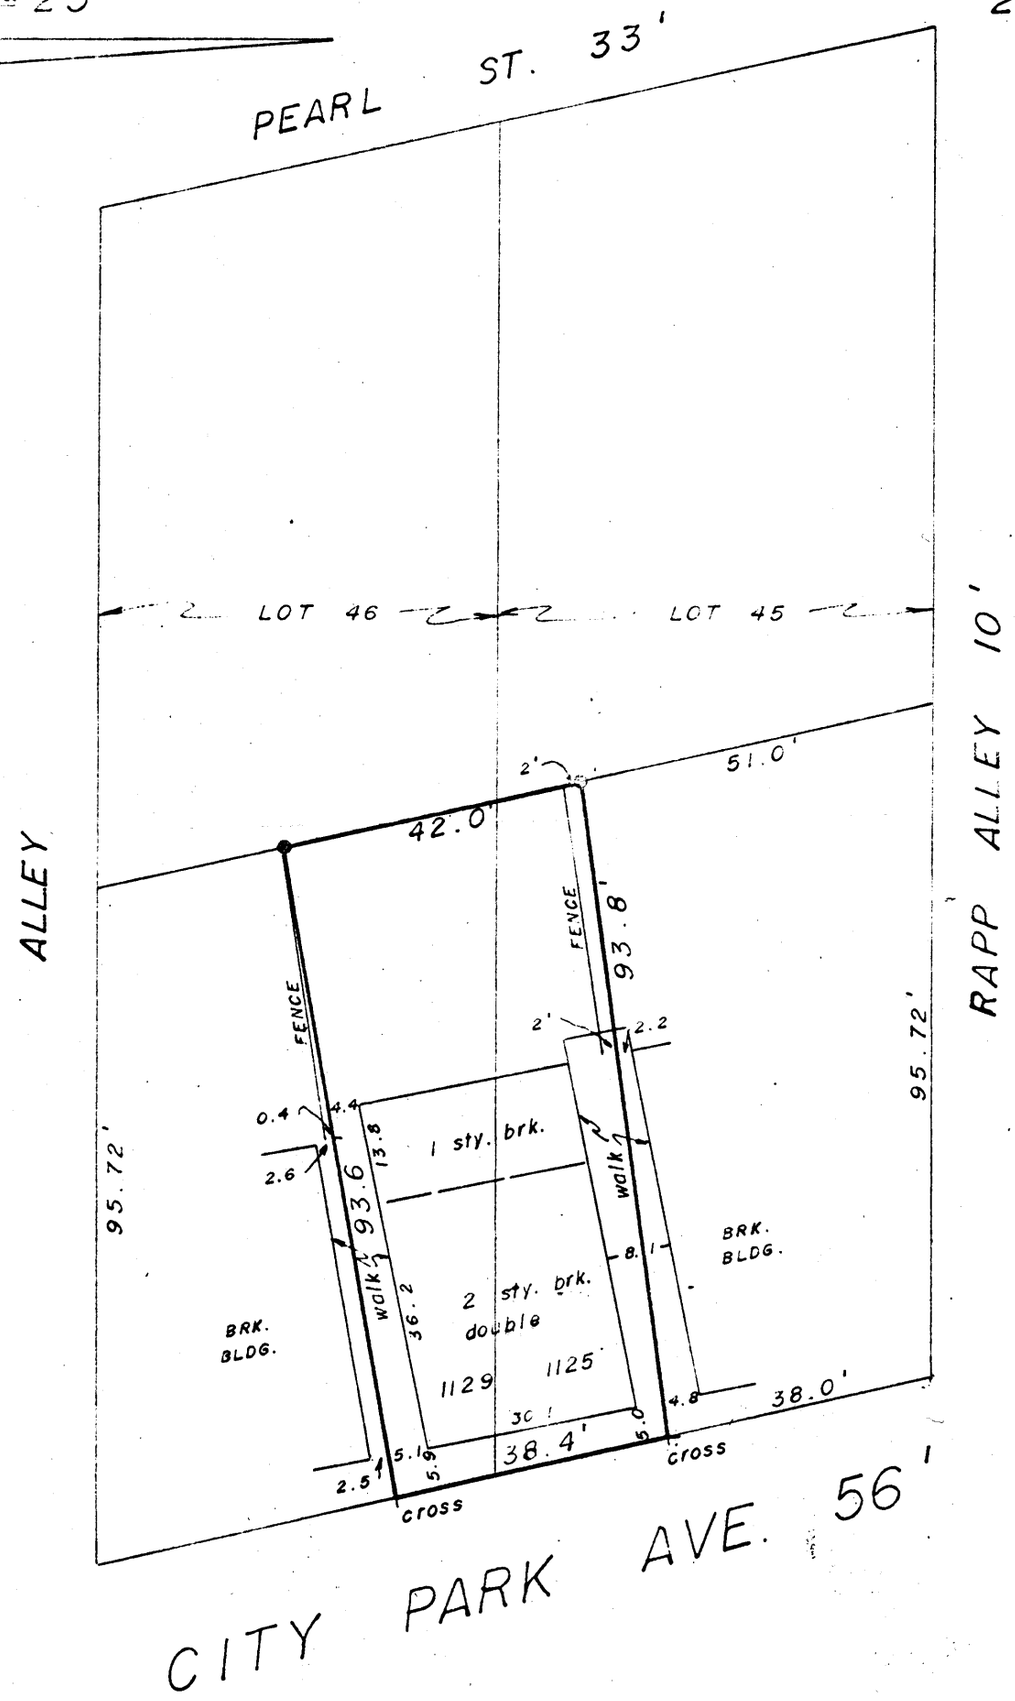

We hereby certify that the foregoing plat was prepared from an actual survey of the premises. No side line of principal building is less than dimension shown. Iron pins not set unless indicated thus —●—. ~~*For Mortgage Loan & Title Insurance purposes only.*~~

MYERS SURVEYING CO.
BY C. O. Myers Jr.
Registered Surveyor