18285/025

MYERS SURVEYING CO.

2740 East Main Street, Columbus 9 (Bexley), Ohio

PART OF LOT 2 GRUEBLER'S SUB. COLUMBUS, OHIO

FOR

MYRA GILLOGLY

K 65

P.B. 10 Page 179
Scale 1" = 15'

Franklin Co. Rec. Office
10-3-'78
Rev. 11-2-79

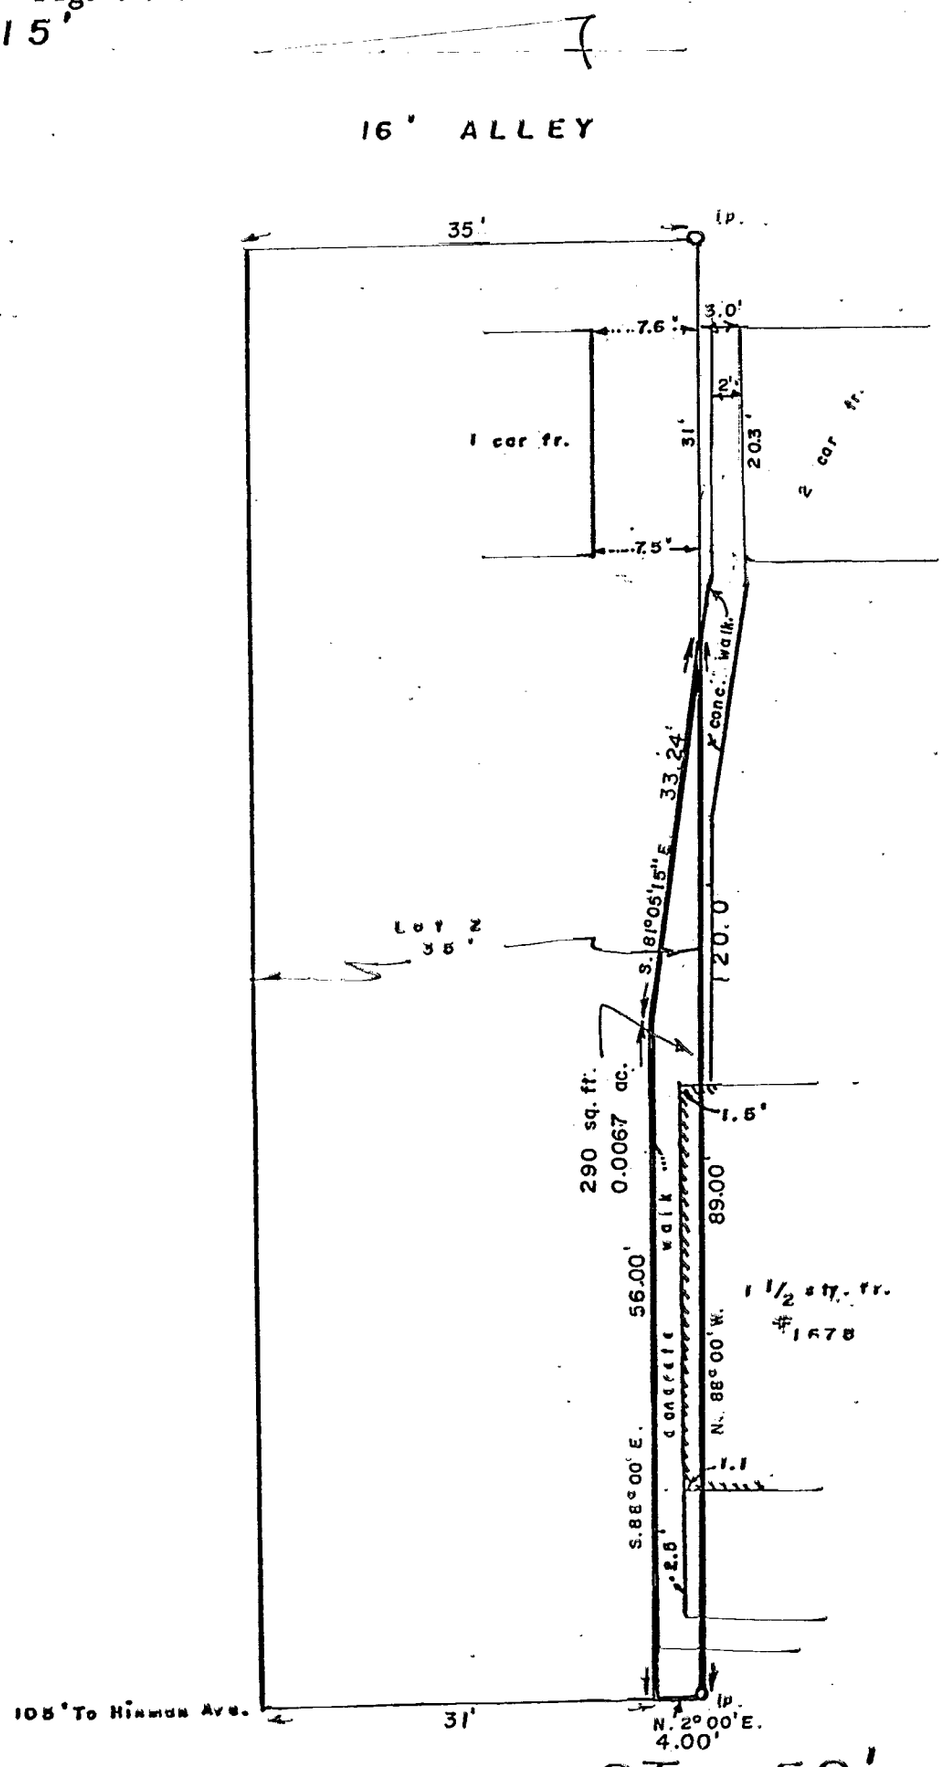

STATE OF OHIO
ALBERT U. MYERS, JR.
3352
REGISTERED SURVEYOR

We hereby certify that the foregoing plat was prepared from an actual survey of the premises. No side line of principal building is less than dimension shown. Iron pins not set unless indicated thus —O—.

MYERS SURVEYING CO.
By Albert U. Myers Jr.
Registered Surveyor #3352