18265 7075

J-34

Myers Surveying Company, Inc.

2740 East Main Street, Columbus 43209 (Bexley), Ohio
614-235-8677 FAX: 614-235-4559

A Boundary Survey prepared for and certified to:
Helen M. & Albert V. Zabonik

Legal Description: Situated in Ohio, County of Franklin, City of Columbus, Being the North Half of Lot 96 C.F. Jaeger's 12th Addition, Plat Book 1, Page 345

Applicant:

Posted Address: 145 E. Lansing Street, Columbus, Ohio

30' 15' 0 30'
Scale: 1" = 30'
Date: 7 · 3 · '95

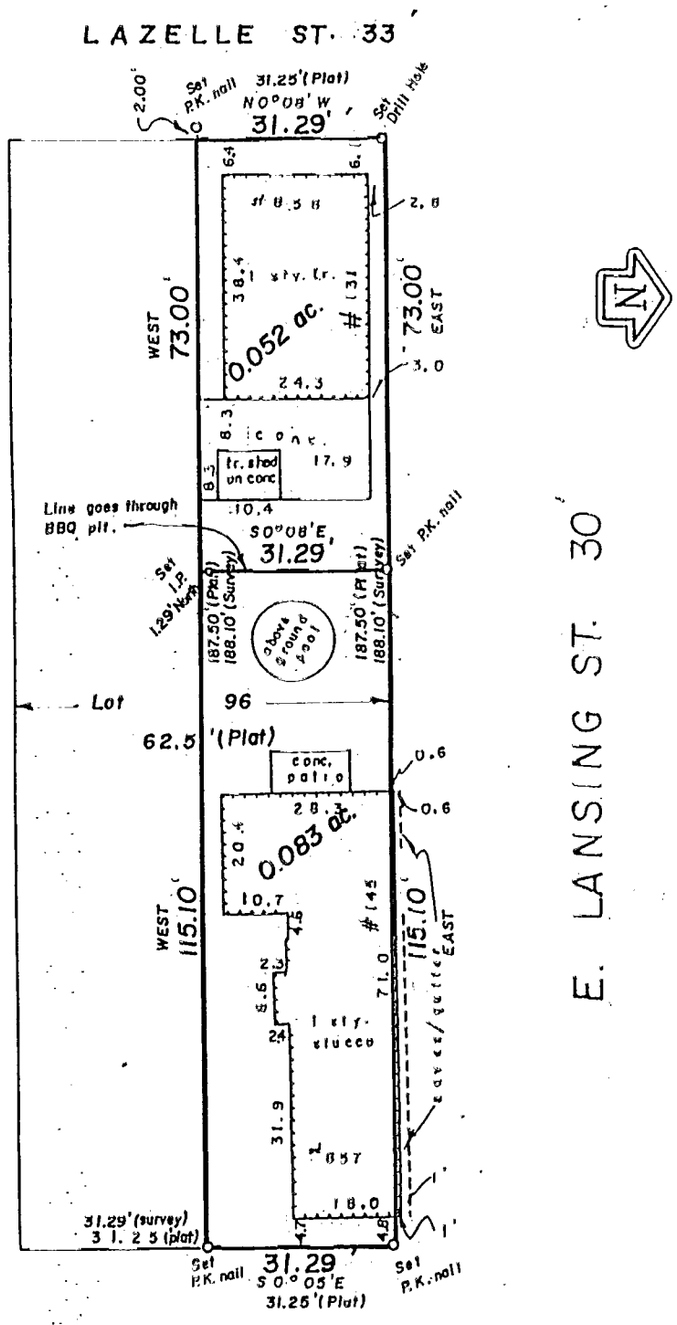

STATE OF OHIO
JOSEPH P MYERS
7361
REGISTERED PROFESSIONAL SURVEYOR

C-34

We hereby certify that the foregoing Boundary Survey was prepared from actual field measurements in accordance with Chapter 4733-37 Ohio Administrative Code. Iron pins set are 30"x1" O.D. with an orange plastic plug inscribed "P.S. 6579", unless otherwise noted. Basis of bearing is the south line of E. Lansing Street assumed EAST.

Myers Surveying Co., Inc.
By Joseph P. Myers
Professional Surveyor

Myers Order No. - 10-04/03/95	Rec.	Field AJM	DWG JPM	Ltr.	Ck.