

78285 7075

# MYERS SURVEYING CO.


2740 East Main Street, Columbus 43209 (Bexley), Ohio

LOT 54 (2 PARCELS) MARIA W. SELBACH'S ADD'N. COLUMBUS, OHIO


## FOR THE ESTATE OF WILLIAM S. BUCHLY

P.B. 3 Page 310  
Scale 1"=15'

Franklin Co. Rec. Office  
8 · 18 · '89

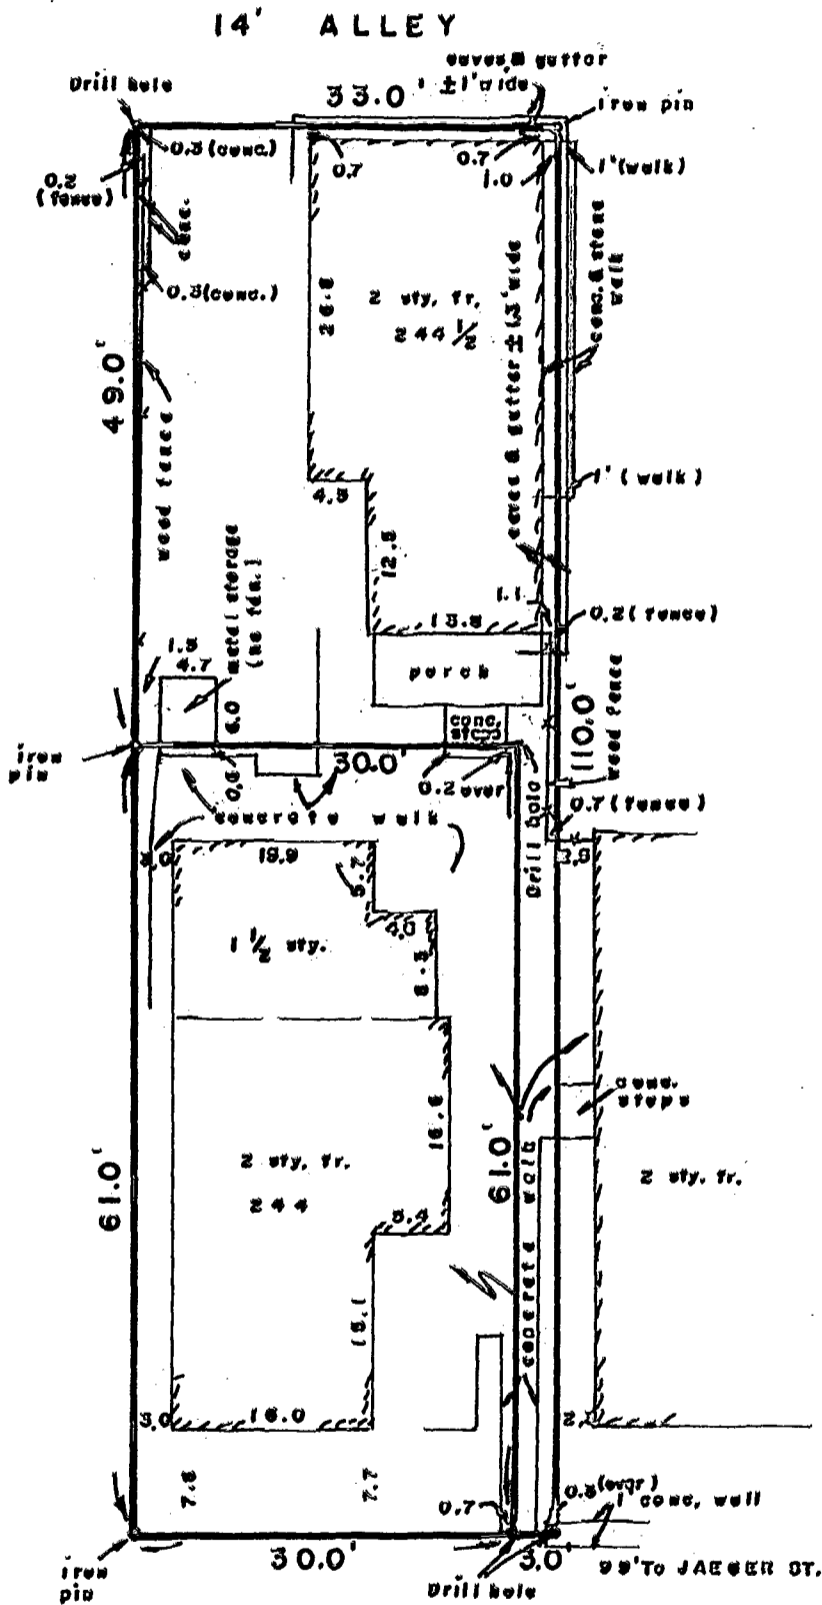

E. WHITTIER ST. 60'

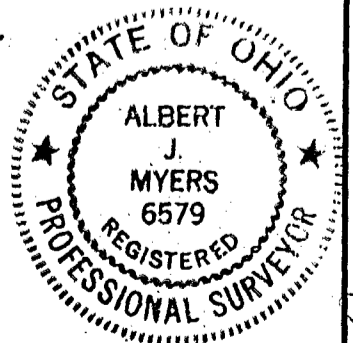

We hereby certify that the foregoing plat was prepared from an actual survey of the premises. Iron pins set are 30" x 1" O.D. with an orange plastic caps inscribed "P.S. 6579".

MYERS SURVEYING CO.

BY *Albert J. Myers*  
Registered Surveyor